


See Superceding Map Next Page

T. 10 & 11 S. R. 26 E. W. W.

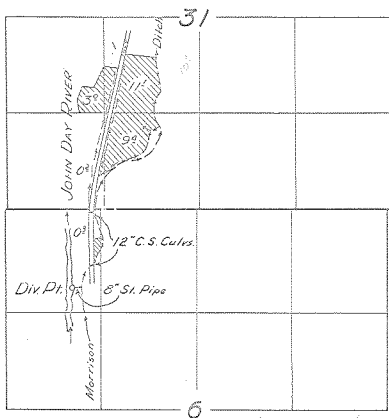

Note highway location in all survey on this map (way out)

FINAL PROOF SURVEY
UNDER

Application No. 30530 Permit No. 24073

IN NAME OF

W. J. FOREE

Surveyed 27 Oct. 1956, by C. A. [Signature]