


T. 7 N. R. 4 W. W. M.

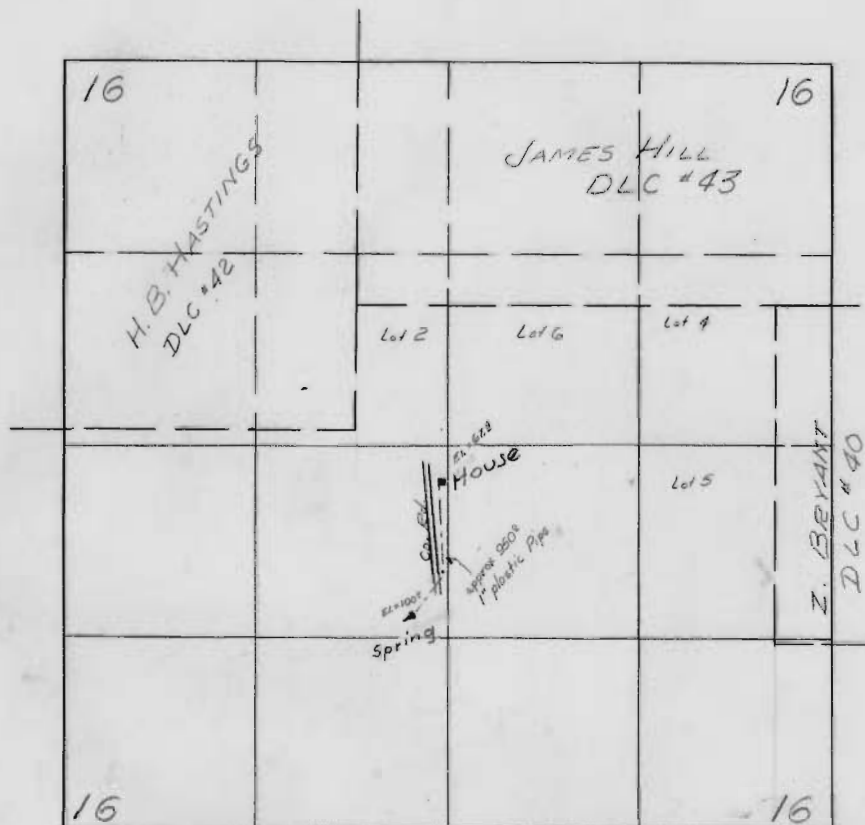

FINAL PROOF SURVEY

IN NAME OF

HARRY M. SAXTON

Application No. 31210, Permit No 24579

Traced from Final Proof Survey 1956V

Rr 16248
APP 20763