


T. 3 N. R. 2 W. W. M.

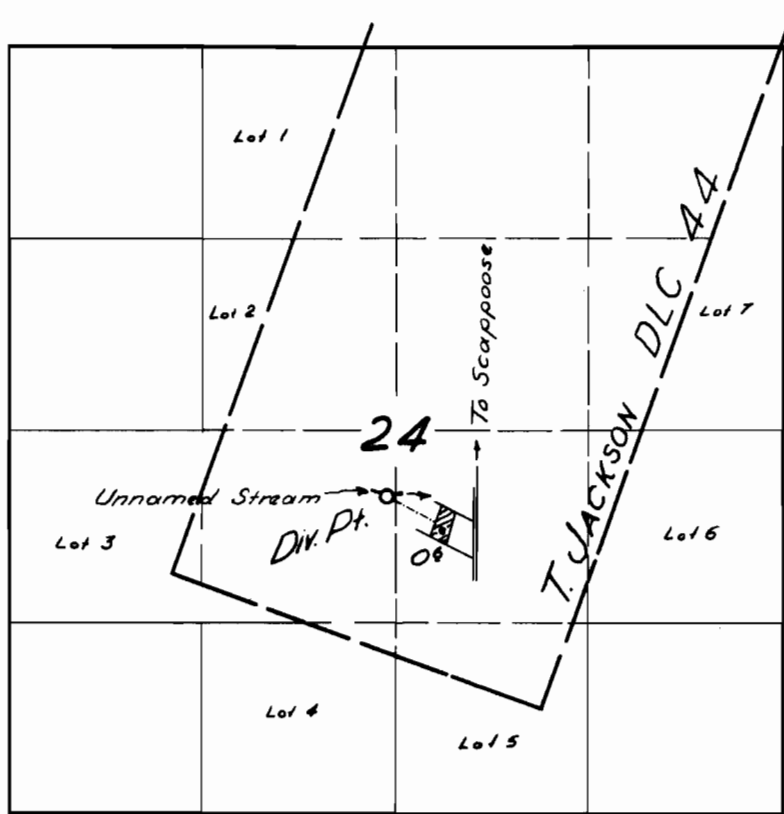

FINAL PROOF SURVEY

UNDER

Application No. 18049 Permit No. 13717

IN NAME OF

HERBERT L. THOMAS

Surveyed 6 Aug 1956, by [Signature]