


T. 2 S. R. 3 E. W. M.

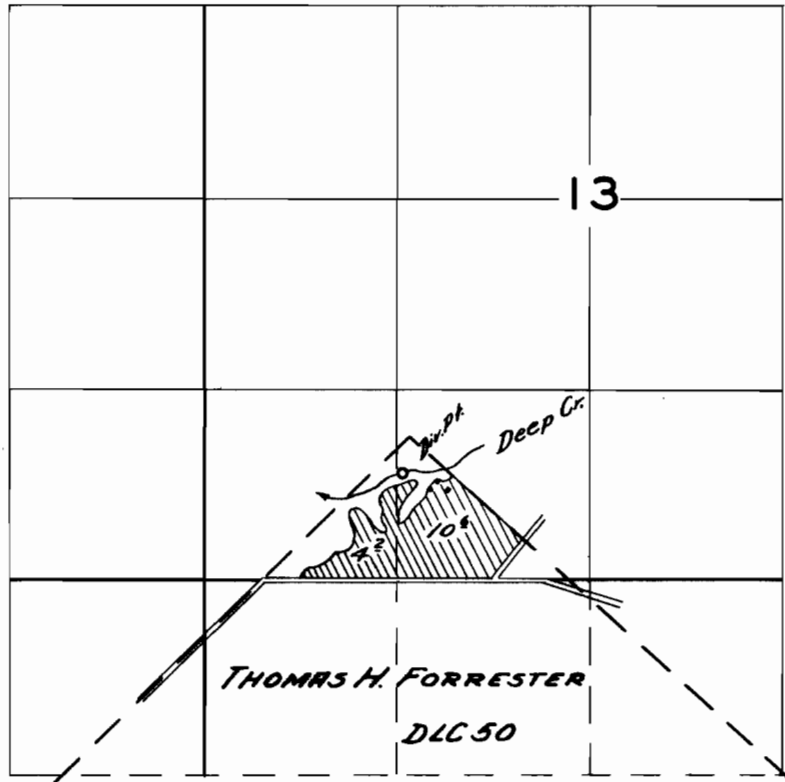

FINAL PROOF SURVEY

UNDER

Application No. *19027* Permit No. *14704*

IN NAME OF

Joseph H. Shuman & Helen Wells Shuman

Surveyed *June 28, 1956*, by *R. H. Whitby*

DFK-10-165