


TIN. R. 3 E. W. M.

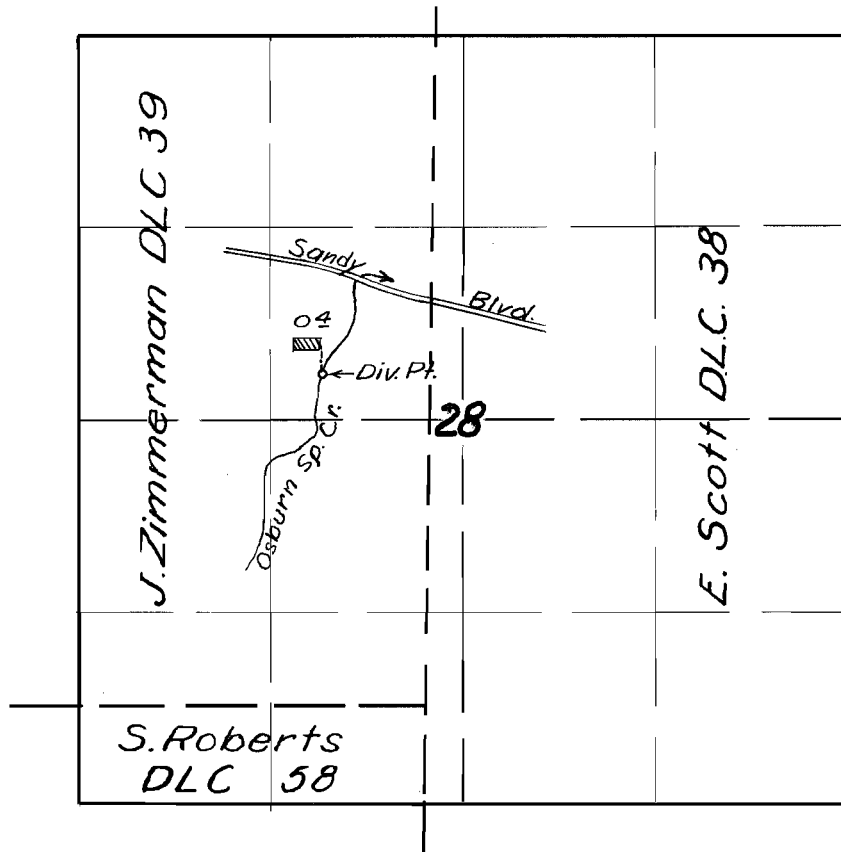

**FINAL PROOF SURVEY**  
UNDER

Application No. 19966. Permit No. 15536.  
IN NAME OF

.....*Maple Dell Steel*.....

Surveyed 27 July 1956, by *Tom Bish*.....