


T. 8 S. R. 3 W. W. M.

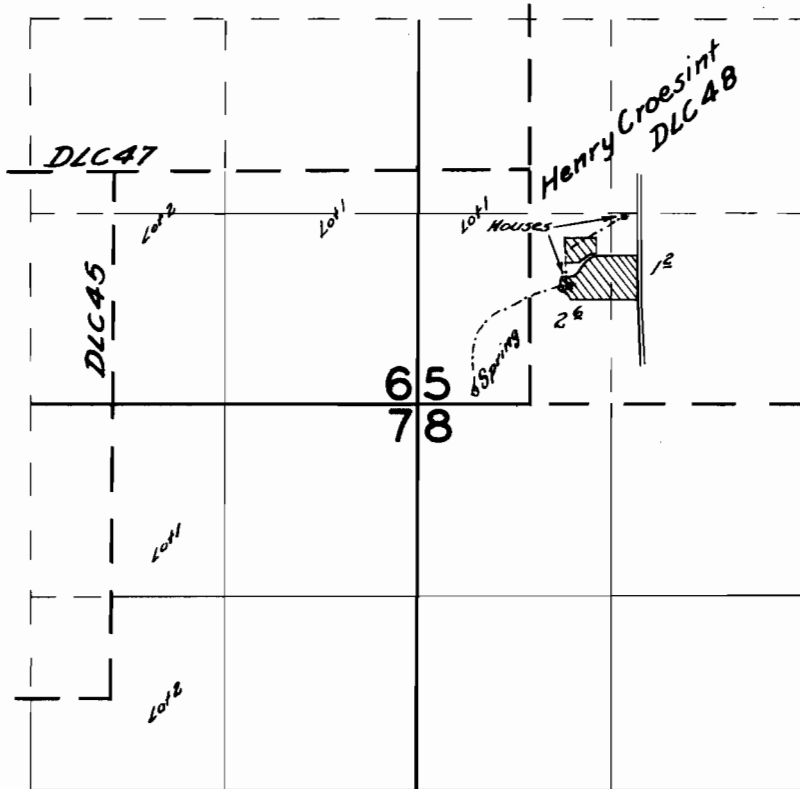

FINAL PROOF SURVEY

UNDER

Application No. 20393 Permit No. 16064

IN NAME OF

Lee Byers

Surveyed June 4, 1956, by R. H. Whitby

DFN-4D-97