


T. 15. R. 4 E. W. M.

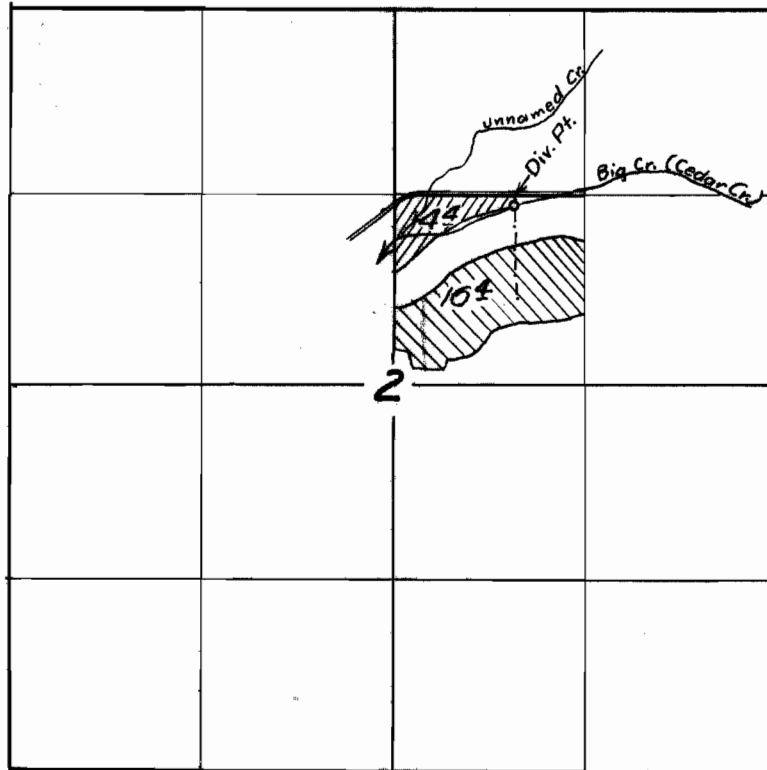

FINAL PROOF SURVEY

UNDER

Application No. 20741 16233
21733... Permit No. 17107...

IN NAME OF

Arthur F. Johnson

Surveyed 30 July 1956, by M. B. Bish

