


T.2S. R.1W. W.M.

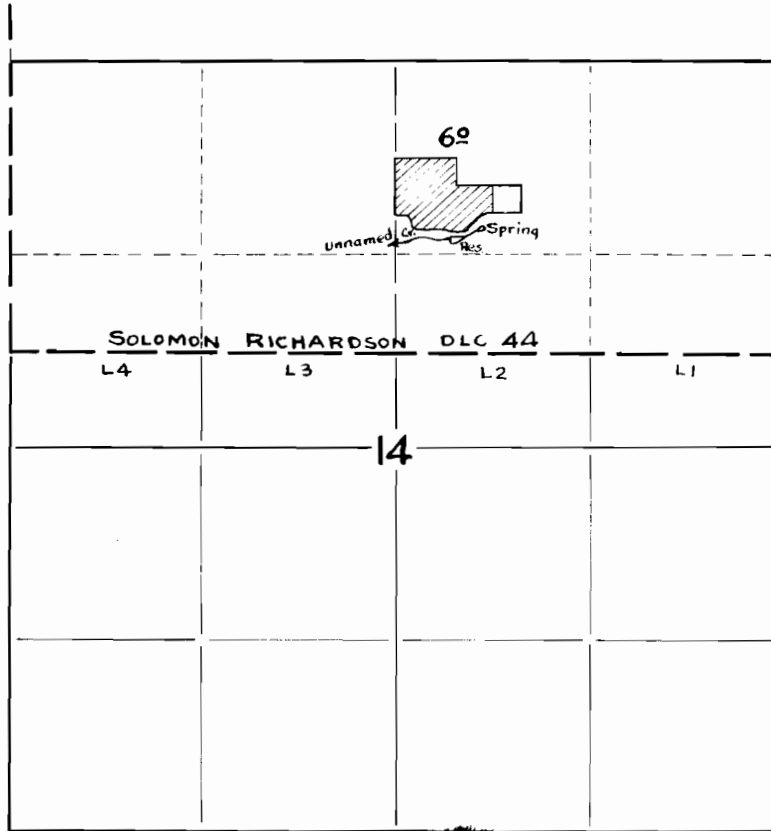

FINAL PROOF SURVEY

UNDER

Application No. 21918 Permit No. 17254

IN NAME OF

DONALD F. DAVIS

Surveyed 5 - 8 1956 by R.H. WHITBY