T.2S. R.1E. W.M.

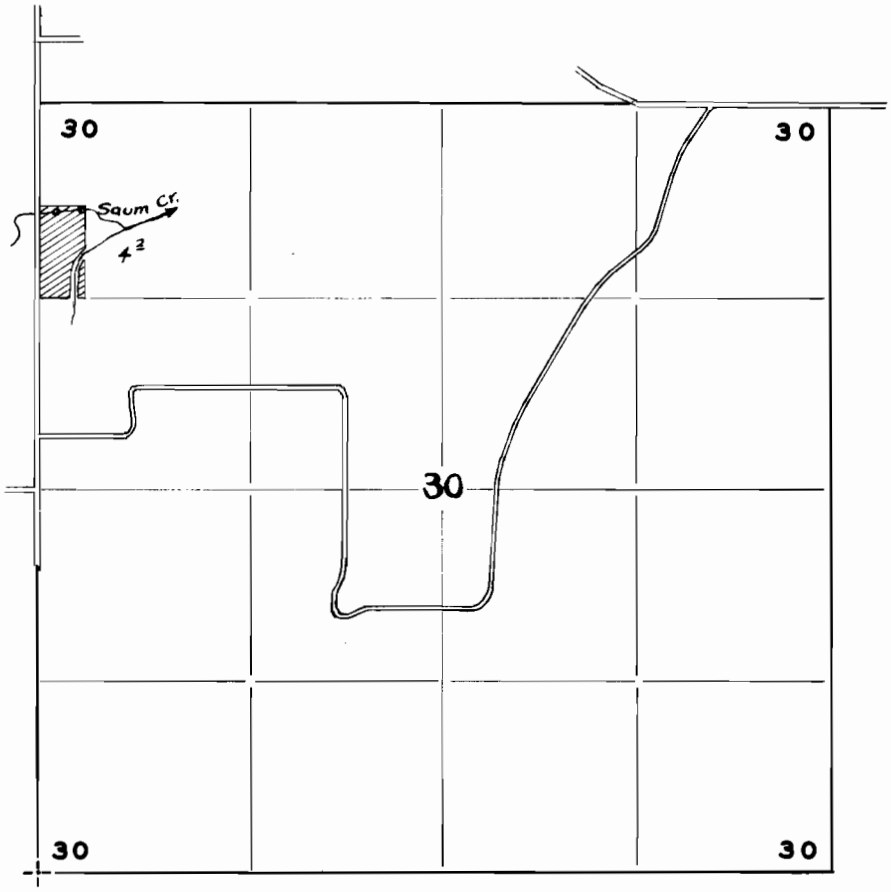

FINAL PROOF SURVEY

UNDER

Application No. 22031 Permit No. 17355

IN NAME OF

PETER J. HILLESLAND

Surveyed 5-10 1956, by R.D. BEST

DFK - 3D - 09 WC