


T. 9S. R. 38E. W.M.

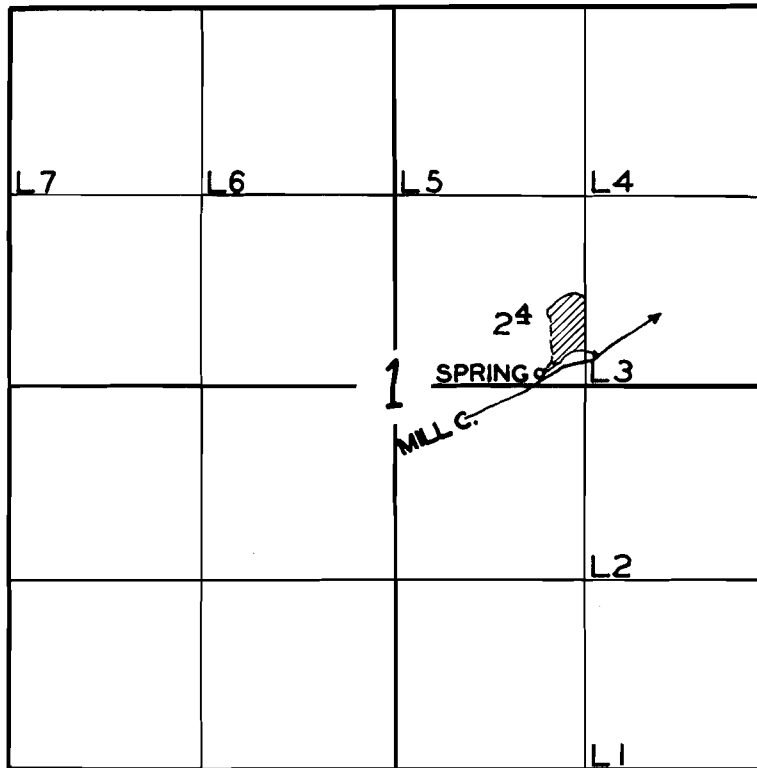

FINAL PROOF SURVEY
UNDER

Application No. 22362 Permit No. 17632
IN NAME OF

ELMER L. HILL

Surveyed 24 MAY 1956, by M. BISH