


T. 8 S. R. 46 E. W. M.

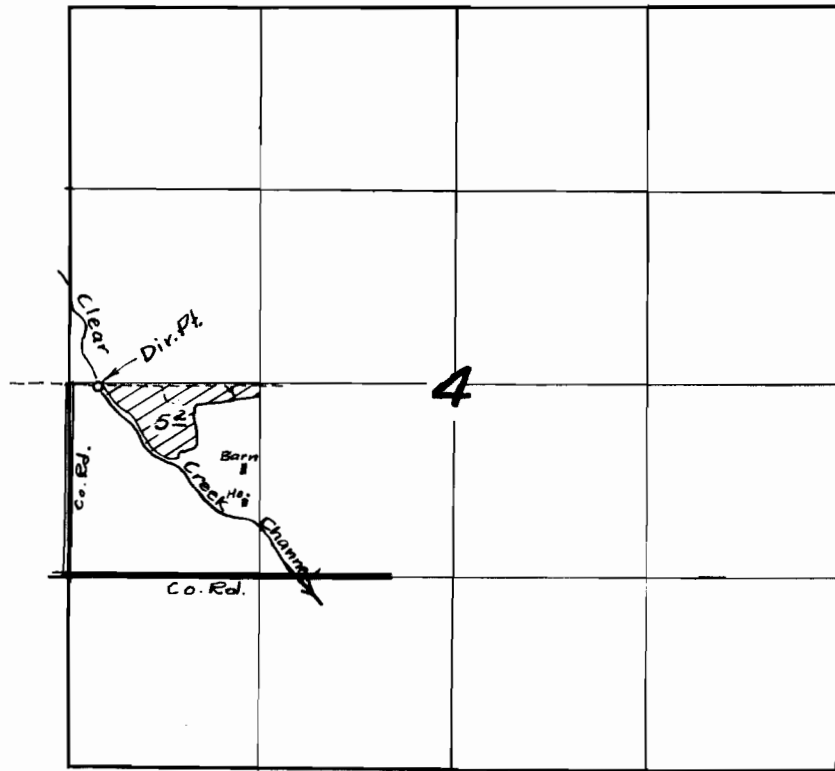

FINAL PROOF SURVEY
UNDER

Application No. 22815... Permit No. 17959...
IN NAME OF

.....Harold Rowen.....

Surveyed 13 Oct. 1956, by M. Bish