T. 3S. R. 2E. W.M.

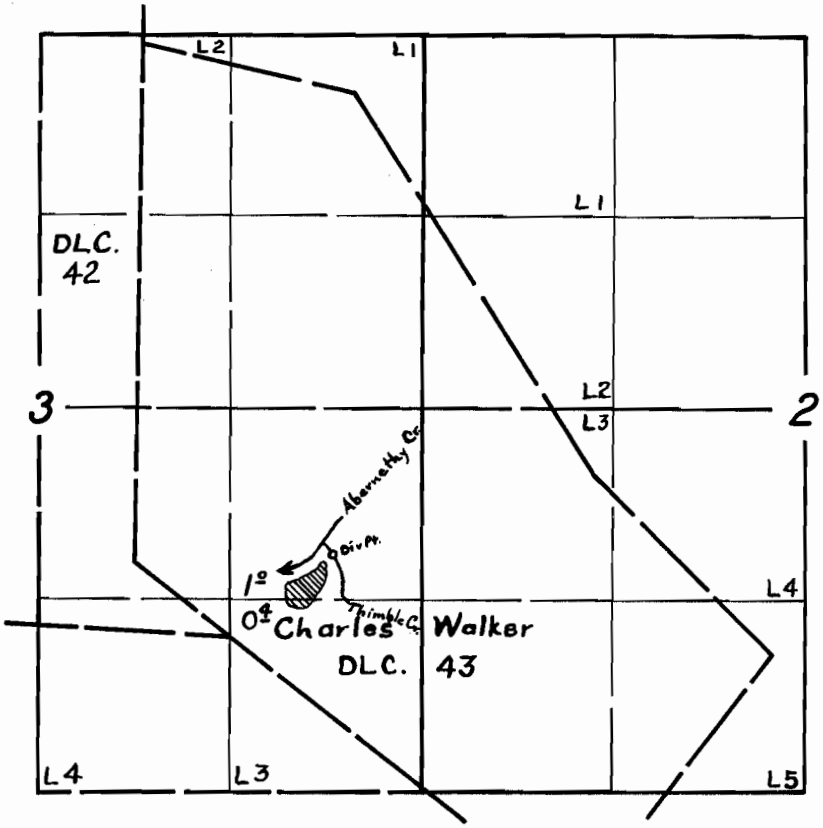

FINAL PROOF SURVEY

UNDER

Application No. 23205 Permit No. 18426

IN NAME OF

ANDREW J. MILLER

Surveyed 27 June 1956, by M. Bish

DFK-10-41