


T. 2 S., R. 2 W., W. M.

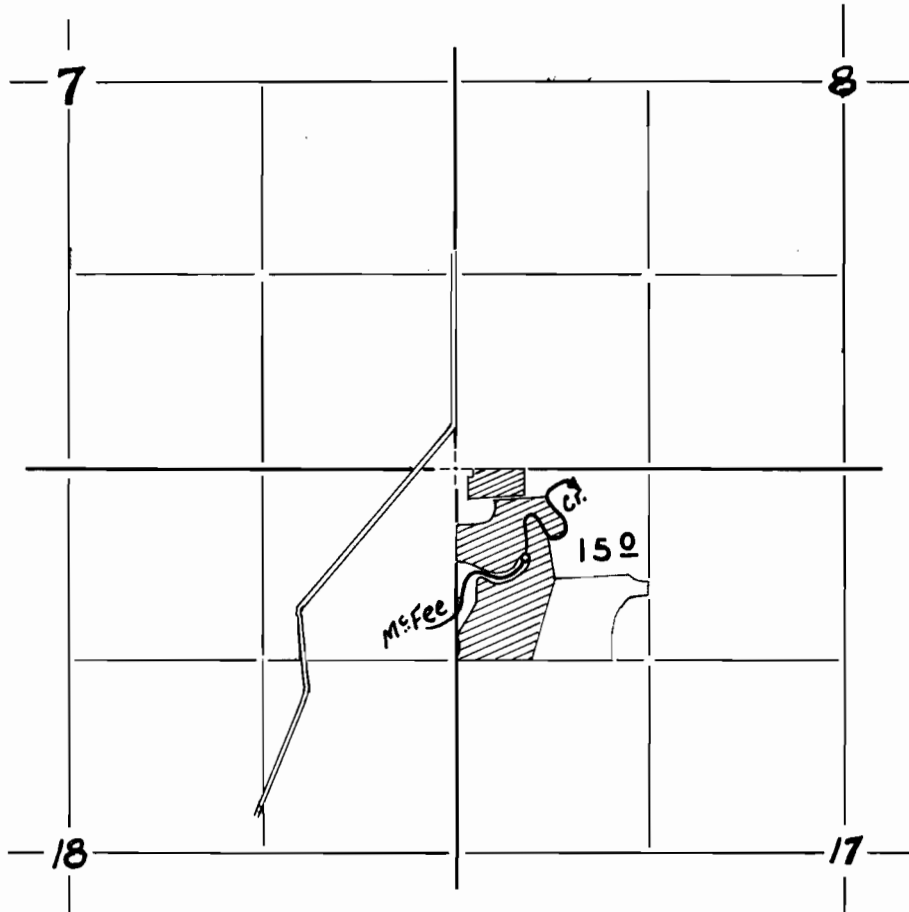

FINAL PROOF SURVEY

UNDER

Application No. 23364 Permit No. 18452

IN NAME OF

E. D. & MRS. E. D. STUCKRATH

Surveyed 5 - 3 1956, by M. BISH