


T. 29 S. R. 5 W. W. M.

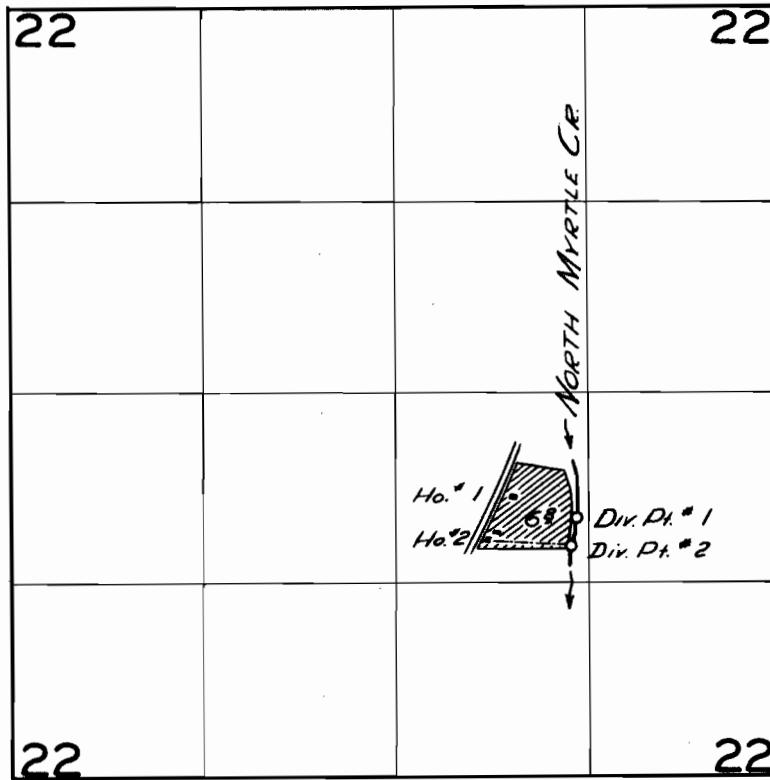

**FINAL PROOF SURVEY**  
UNDER

Application No. 23744 Permit No. 19091  
IN NAME OF

..... JAMES A. GRAF .....

Surveyed Sept. 22 1956, by [Signature]