


T. 7 N. R. 10 W. W. M.

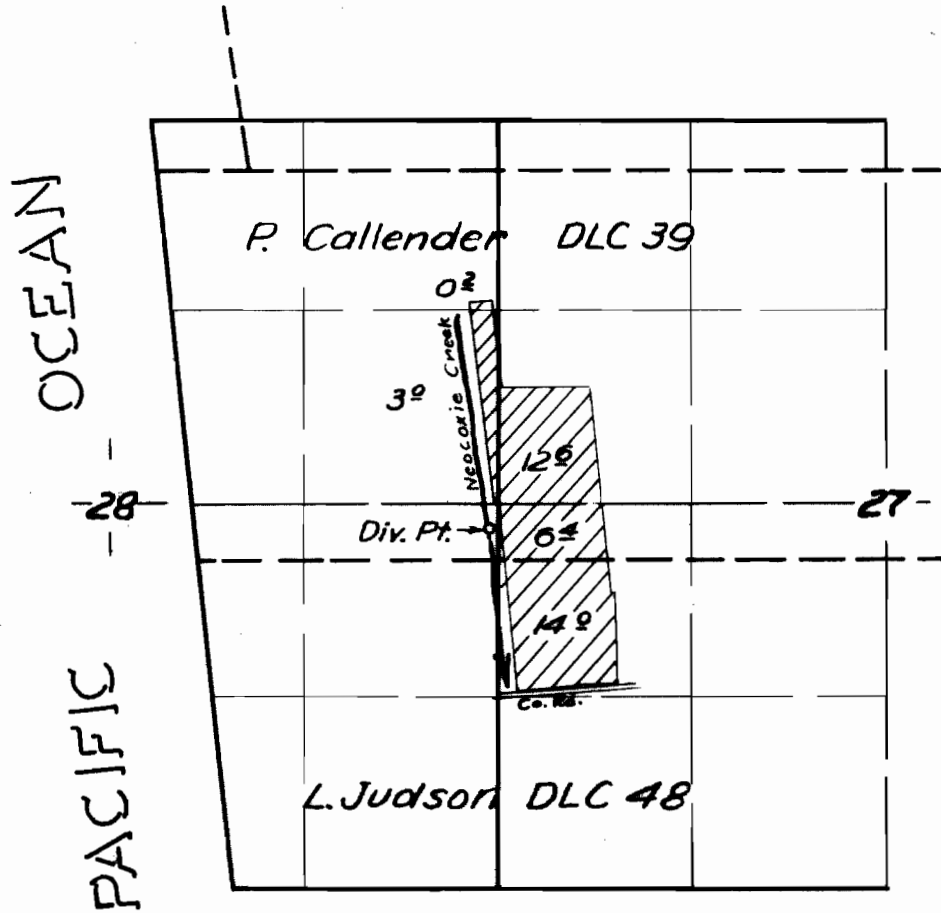

FINAL PROOF SURVEY
UNDER

Application No. 23829 Permit No. 19434
IN NAME OF

Clarence R. & Pauline Earl

Surveyed 11 Sept. 1956, by Tom Bush