


T. 2 S., R. 2 W., W.M.

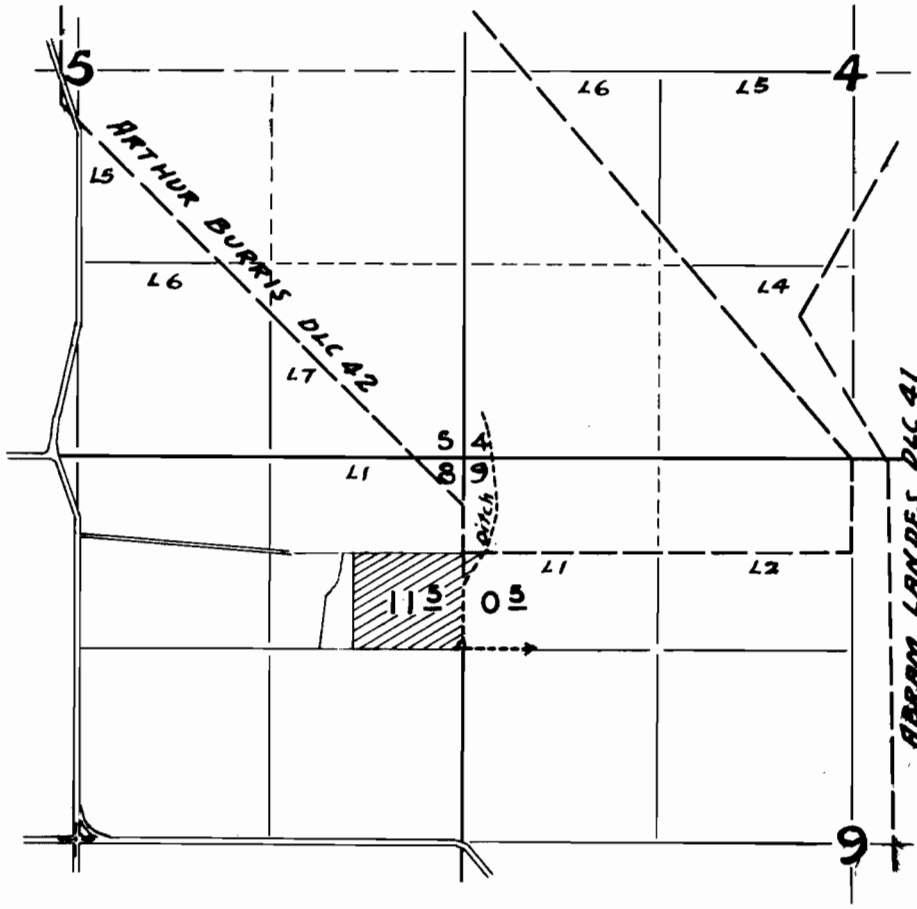

FINAL PROOF SURVEY

UNDER

Application No. 23849 Permit No. 18859

IN NAME OF

J. B. TWIFORD

Surveyed 5 - 2 1956 by M. BISH