


T. 4S. R. 1E. W.M.

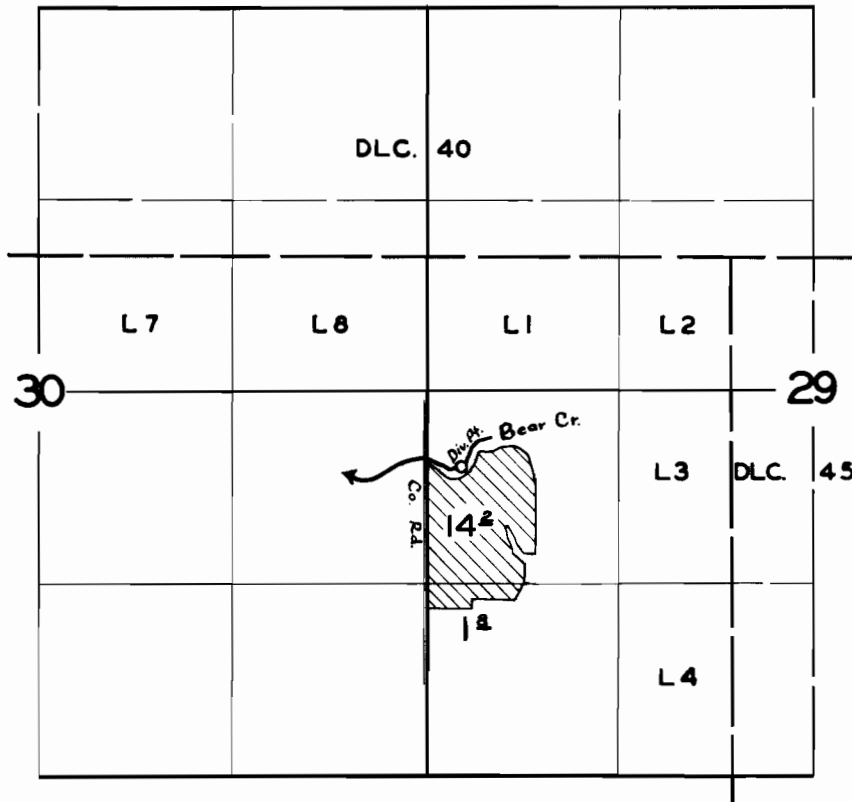

FINAL PROOF SURVEY
UNDER

Application No. 24002 Permit No. 19190
IN NAME OF

WALLACE & GERALDINE PETERSON

Surveyed 8 MAR. 1956, by R.D. BEST