


T. 3N R 2W W.M.

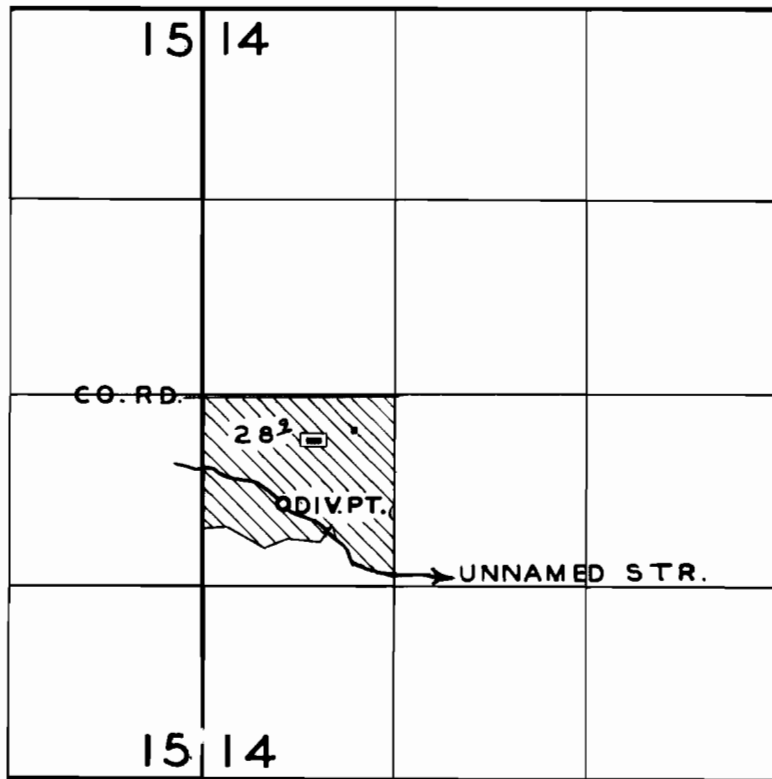

FINAL PROOF SURVEY

UNDER

Application No. 24154 Permit No. 19004

IN NAME OF

T. R. MCCONNELL

Surveyed AUG. 1 1956 by R. H. WHITBY

1956 V
L.W.G.