


T. 1 N., R. 2 W., W. M.

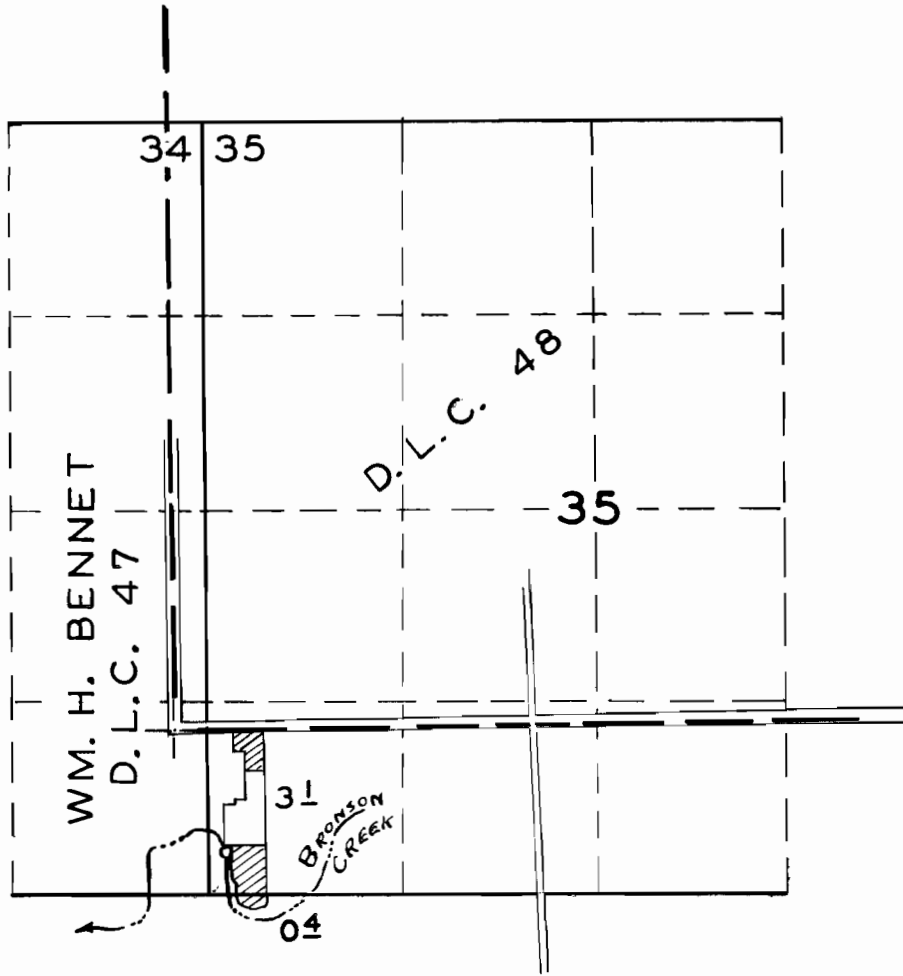

FINAL PROOF SURVEY

UNDER

Application No. 24303 Permit No. 19058

IN NAME OF

ERWIN SPRINGER

Surveyed 4 - 10 1956, by M. BISH