


T. 4 S., R. 2 W., W. M.

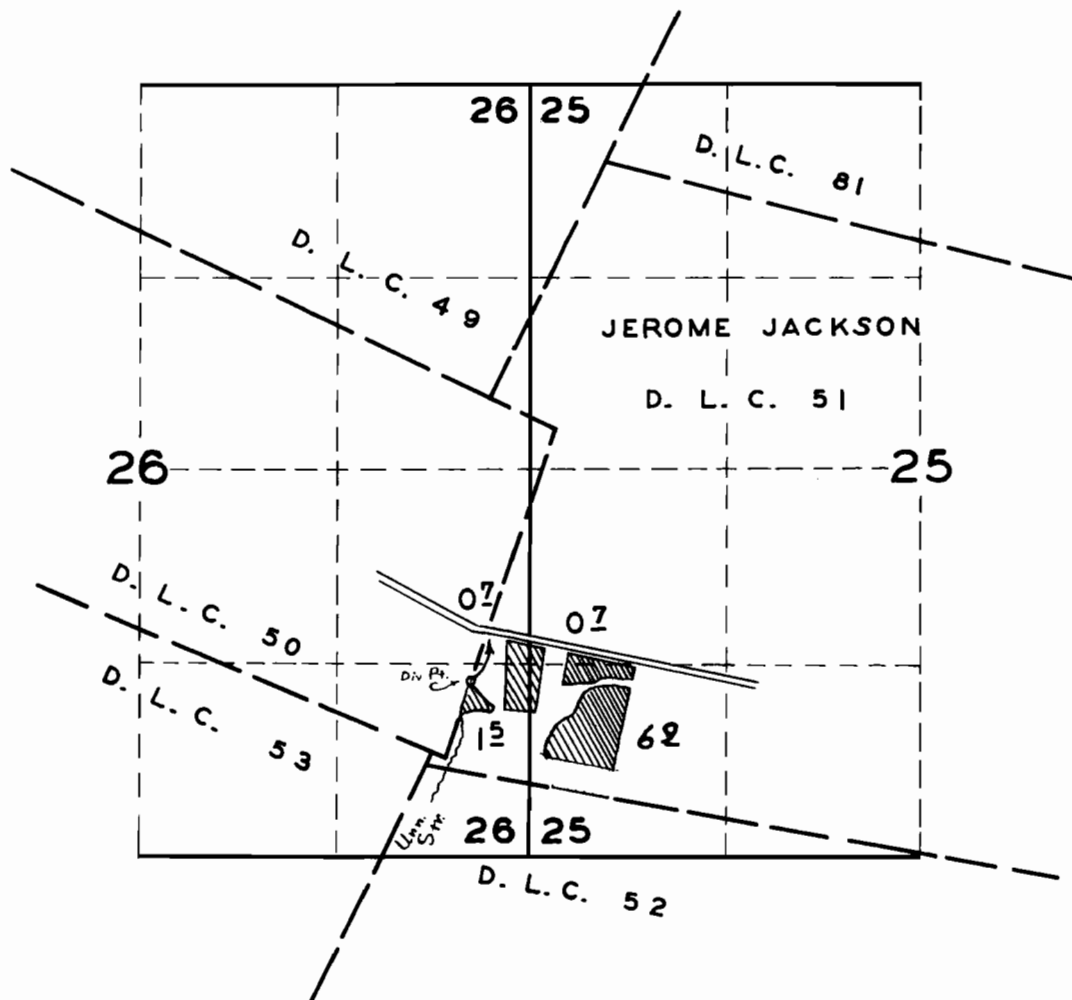

**FINAL PROOF SURVEY**

UNDER

Application No. 17845. Permit No. 13531.

IN NAME OF

HAROLD & DELPHA CRANE

Surveyed 9 - 19 1956, by M. BISH