


PLAT SHOWING
 THE PROPERTY OF MARY ELLIS
 THE N. 1/2 OF N.E. 1/4 AND THE NE. 1/4 OF N.W. 1/4
 SECTION 21 T. 38 S. R. 4 W., W.M. OREGON
 SCALE: 1" = 200'

I, John B. White, of Grants Pass, Ore. do hereby certify that this map was made from notes taken during an actual survey made under my immediate supervision on the 19th day of July, 1947, and that it correctly represents the works described in the accompanying application, together with the location of streams and other ditches in the immediate vicinity

John B. White
 Signature of Affiant

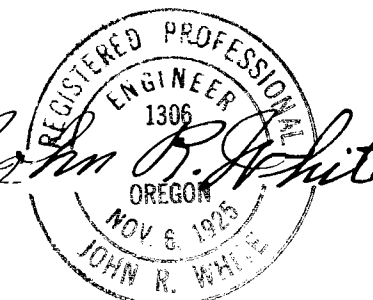

22707

NE. Cor. Sec. 21
 T. 38 S. R. 4 W.
 W.M. Oregon

Mon. P.M. P.
 ON 3/5 EC. LINE
 5.21° 50' W. 10.77'
 Tie from Mon. to Pump