


T. 1 N. R. 38 E. W. M.

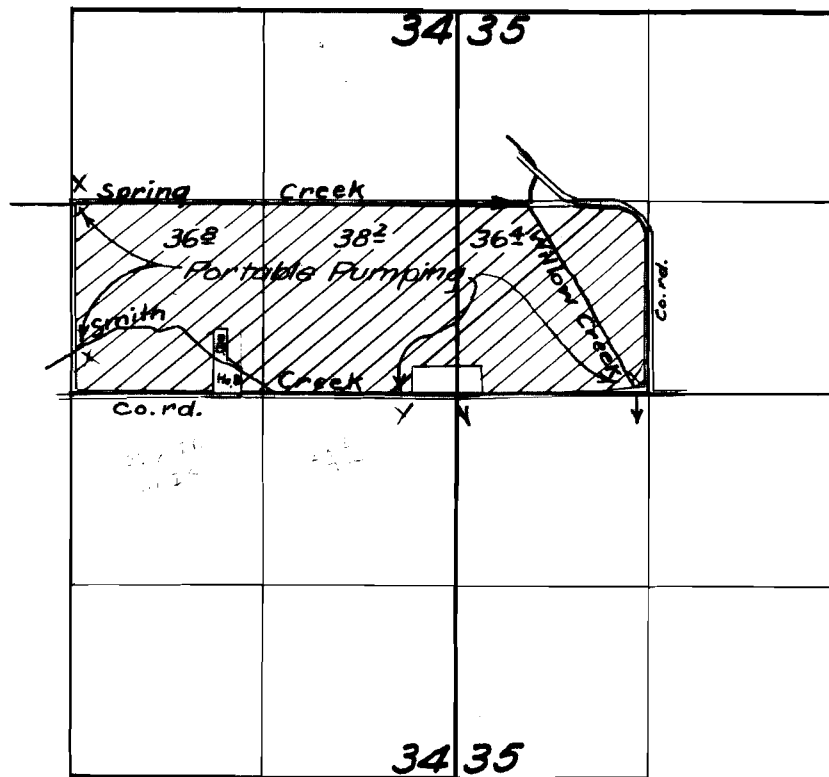

# FINAL PROOF SURVEY

UNDER


Application No. 24170 Permit No. 19914

IN NAME OF

R.E. Pointer & Dorey L. Pointer

Surveyed 8 & 9 Nov 1956, by Tm. Bish

T. 1 N. R. 38 E. W. M.

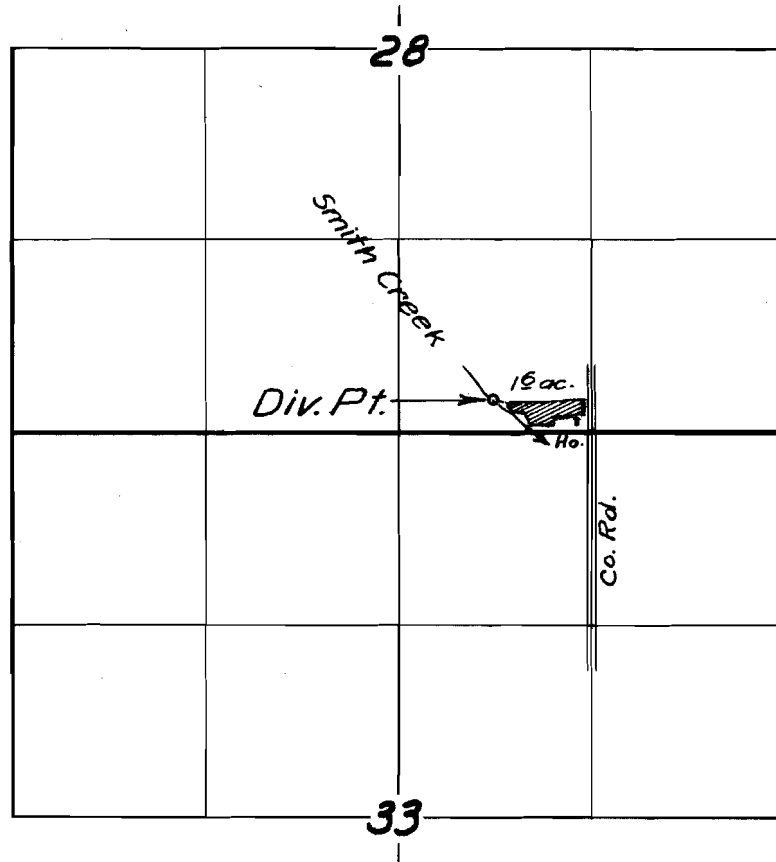

**FINAL PROOF SURVEY**  
UNDER

Application No. 24170 Permit No. 19114.....  
IN NAME OF

ALBERT & VESTA SAILER

Surveyed 8 NOV 1956, by Tm. B. S. S.