


T. 2 S., R. 1 W., W.M.

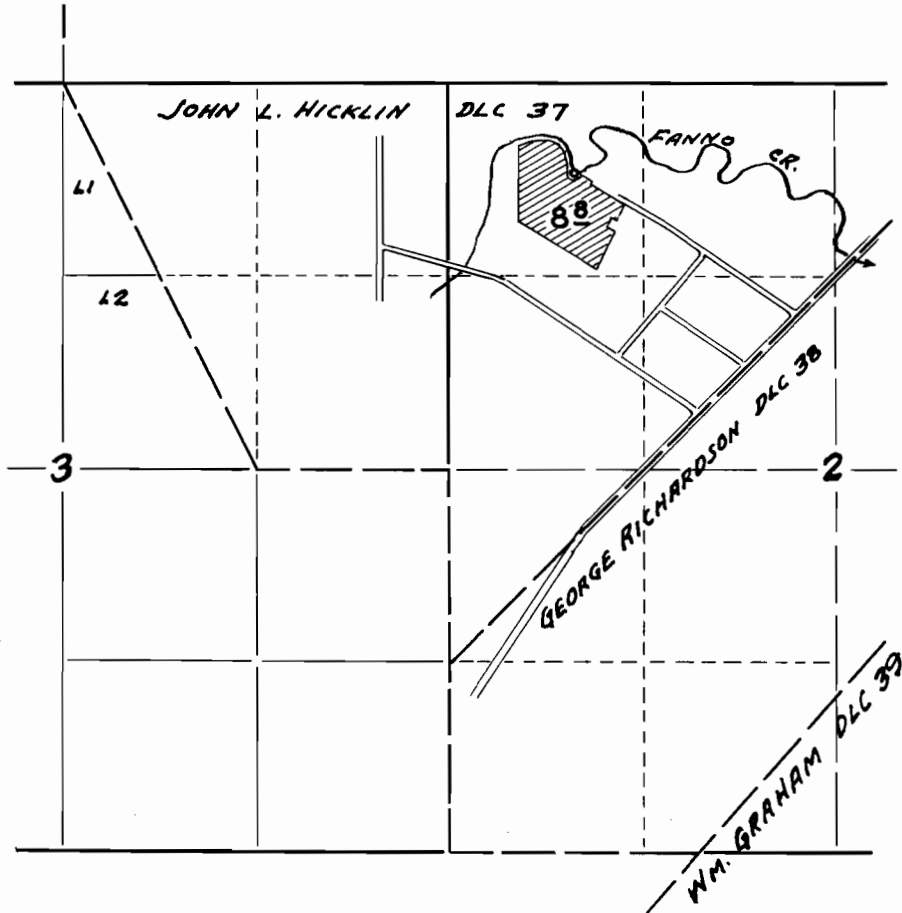

**FINAL PROOF SURVEY**

UNDER

Application No. 24419 Permit No. 19257

IN NAME OF

JOHN HERMAN & EMILY A. MOELLMAN

Surveyed 5 - 7 1956 by M. BISH