


T.10 S. R.1 W.W.M.

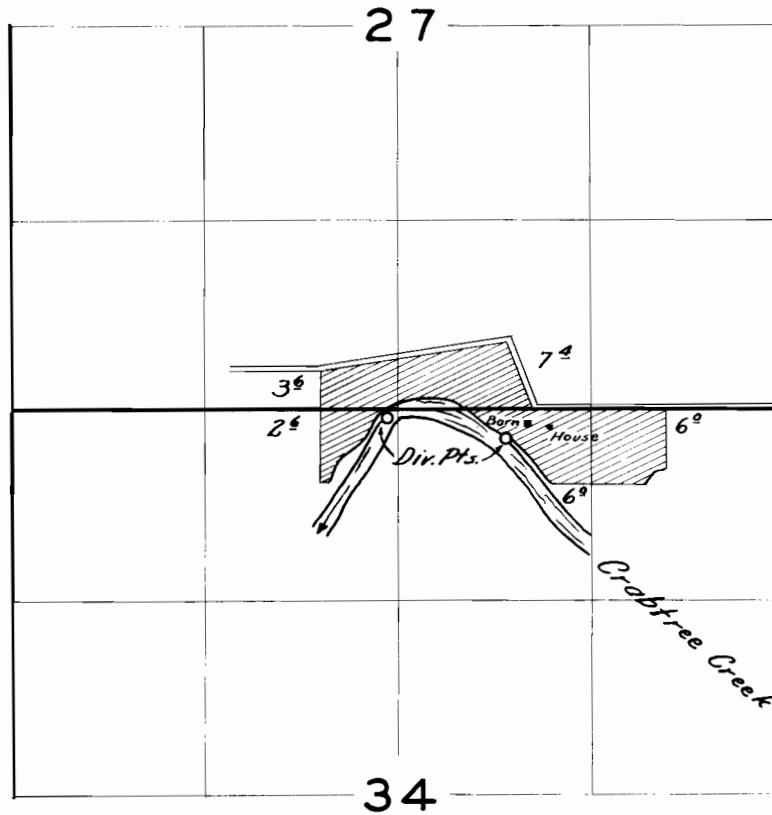

FINAL PROOF SURVEY

UNDER

Application No. *24584* Permit No. *19373*

IN NAME OF

John Flande

Surveyed *July 27 1956* by *C.O. Bartels*