


T. 5 N. R. 2 W. W. M.

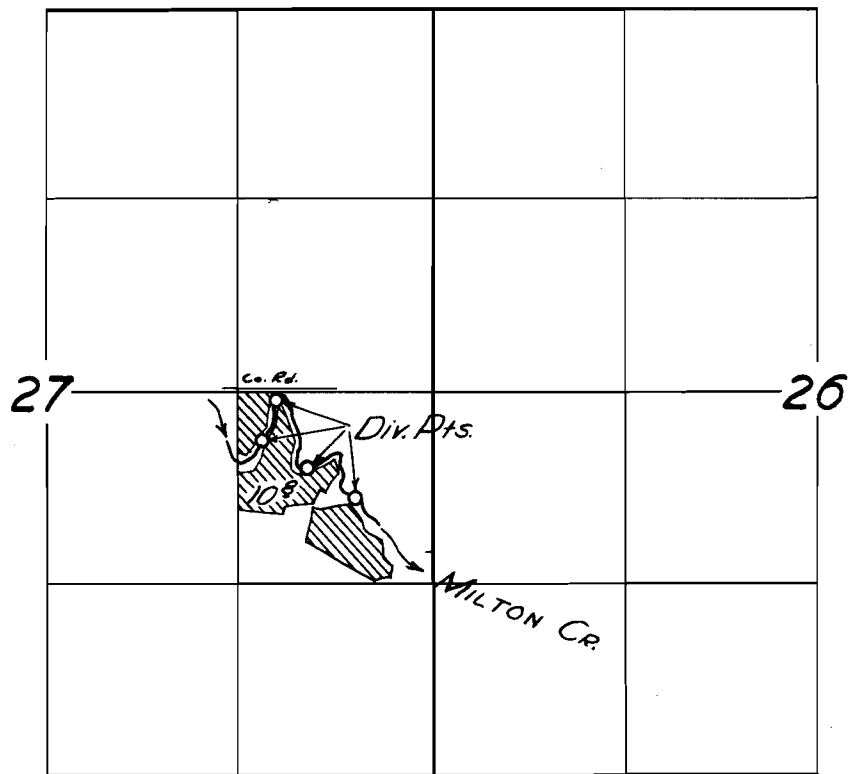

FINAL PROOF SURVEY

UNDER

Application No. 24616 Permit No. 19385

IN NAME OF

ORRIN H. RIGGS

Surveyed 20 July 1956, by *P. H. Riggs*