


T. 2 S., R. 2 W., W. M.

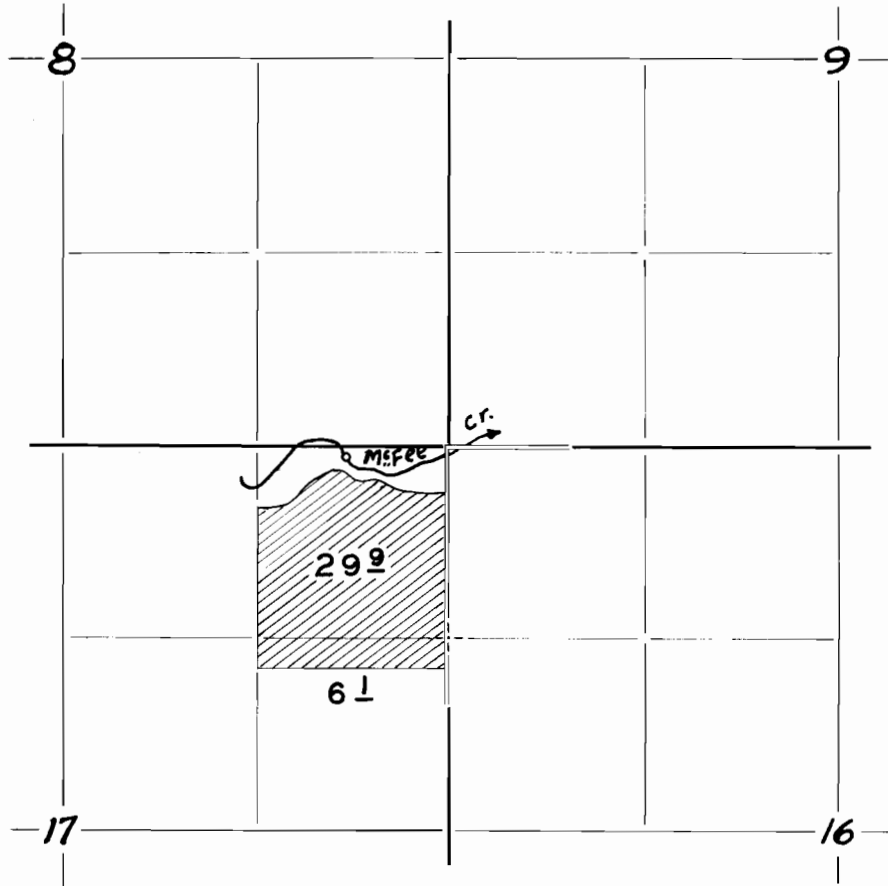

FINAL PROOF SURVEY

UNDER

Application No. 24625 Permit No. 19469

IN NAME OF

VICTOR & FLORENCE WENSTROM

Surveyed 5 - 2 1956, by M. BISH