


T. 4 S. R. 1 W. W. M.

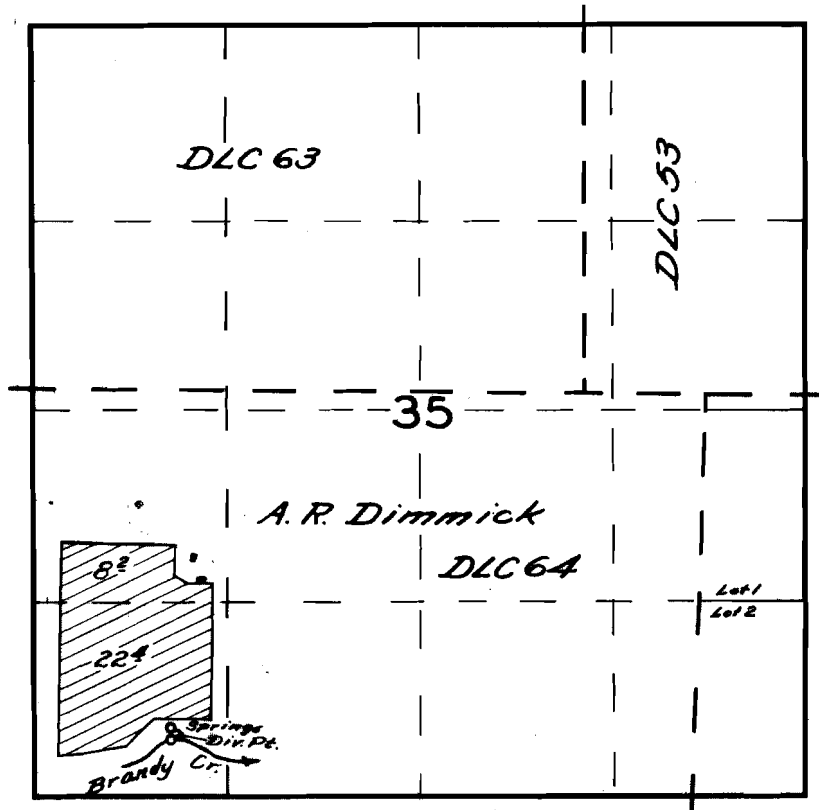

**FINAL PROOF SURVEY**

UNDER

Application No. 24828 Permit No. 19549

IN NAME OF

James McNulty

Surveyed Sept. 19, 1956, by M. Bisk