


T. 5N R. 2W W. M.

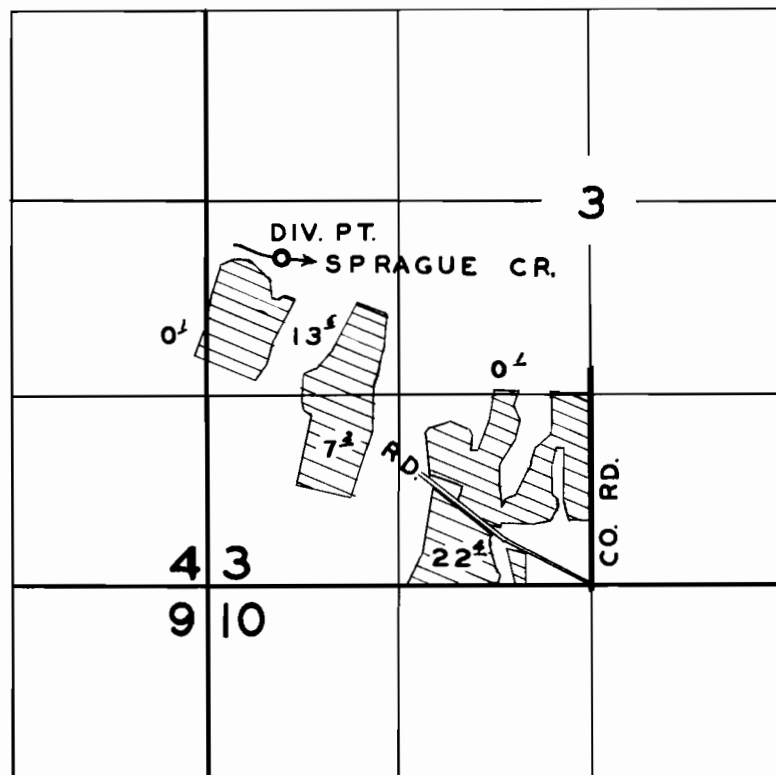

FINAL PROOF SURVEY
UNDER

Application No. 24891... Permit No. 19683.....
IN NAME OF

LONGEN BROS.

Surveyed AUG. 25, 1956, by R.H. WHITBY....

1956 V
J.W. L