


T.6 S. R.1 E.W.M.

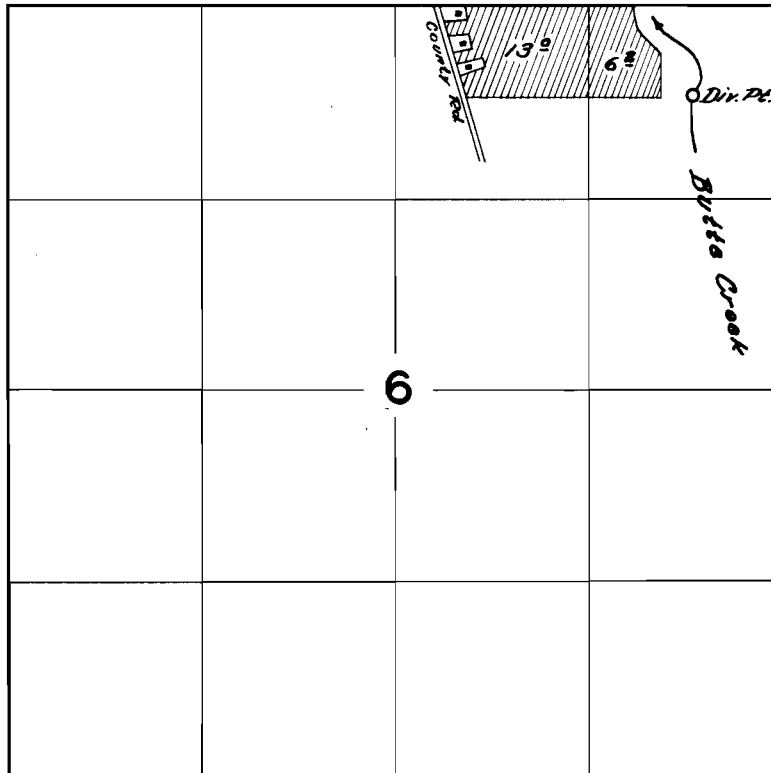

FINAL PROOF SURVEY

UNDER

Application No. 24644 Permit No. 19926

IN NAME OF

REX ROSS

Surveyed July 16 1956, by M. BISH