
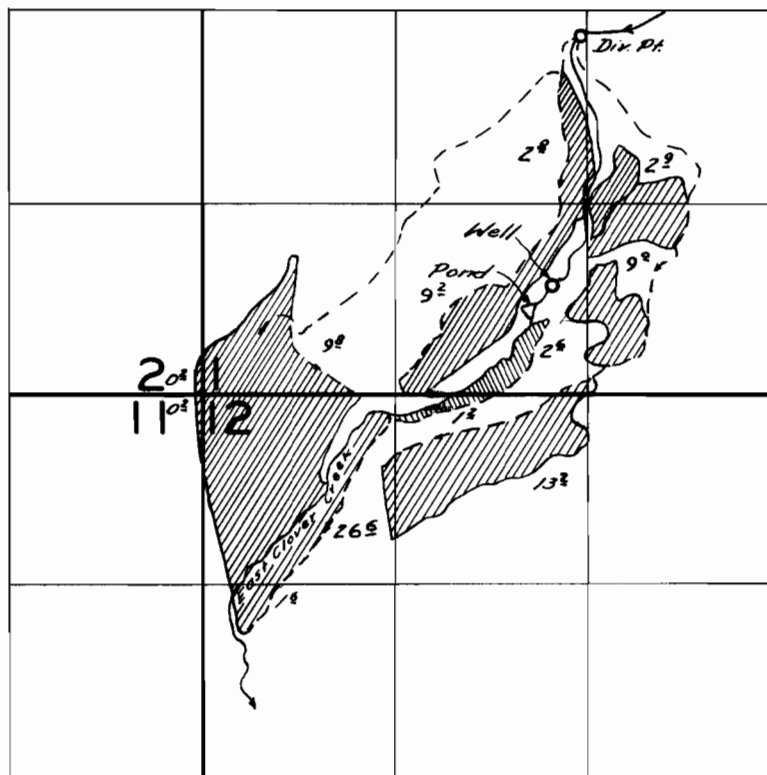


T. 8 S. R. 42 E. W.M.

 

24859 
U-409 

FINAL PROOF SURVEY

UNDER

Application No. ^{U-409}~~24859~~ Permit No. ^{U-379}~~19935~~
IN NAME OF

JESSE L. COOK

Surveyed May 28 1956, by M. Bish

BBB-7N-10

C.B.