


T. 4S. R. 1W. W.M.

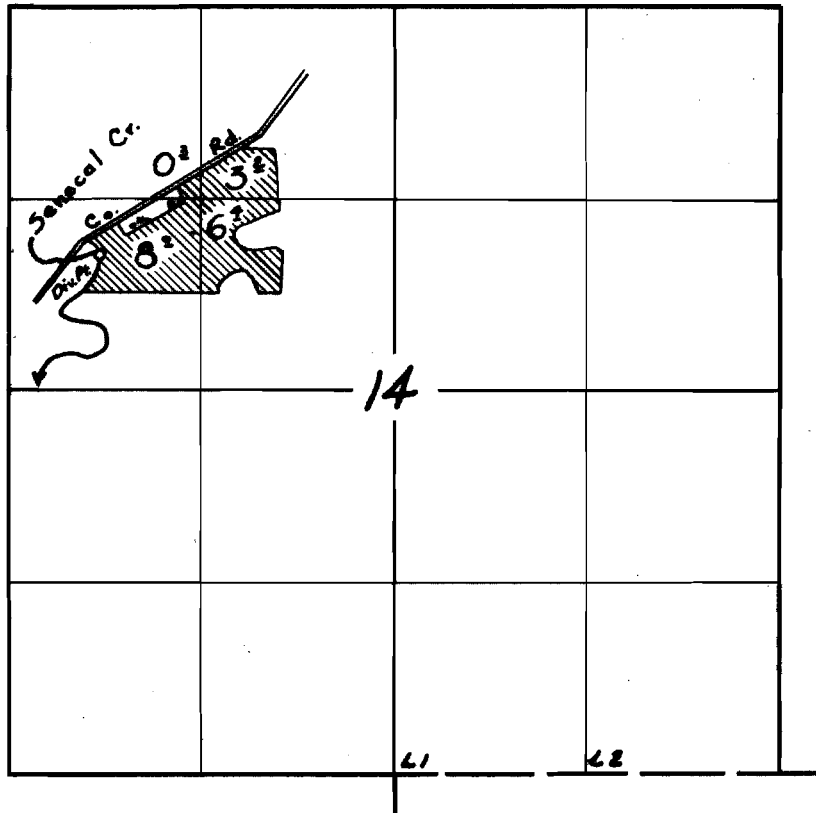

FINAL PROOF SURVEY

UNDER

Application No. 25219 Permit No. 19959

IN NAME OF

Joe Ezzell

Surveyed 26 Sept 1956, by M. Bish

DFN-2D-18

6/24