


T.6 S. R. 1 E. W. M.

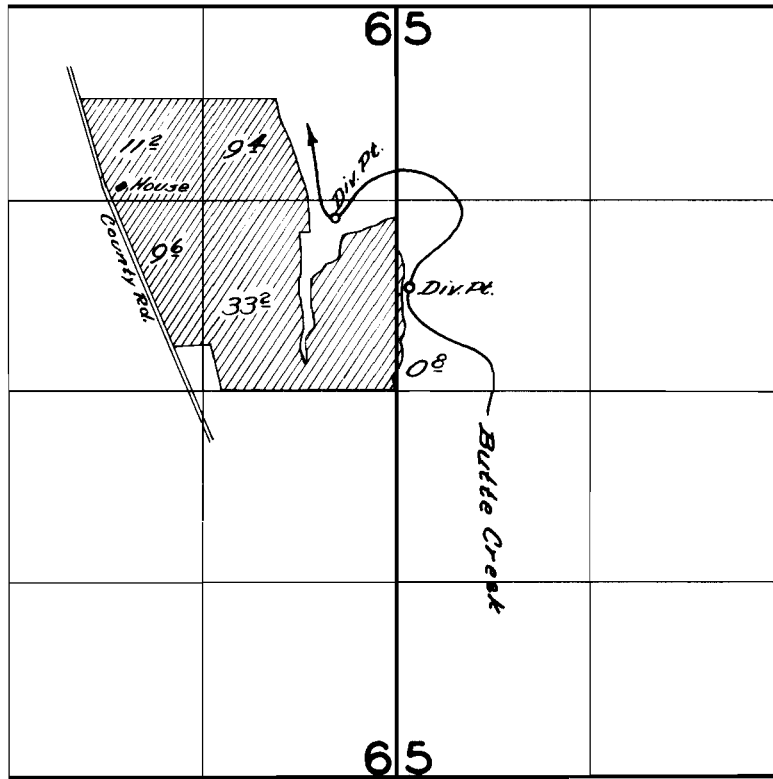

FINAL PROOF SURVEY

UNDER

Application No. *25470* Permit No. *20021*

IN NAME OF

Merton O. White

Surveyed *July 17, 1956*, by *M. Bisk*