


T. 6 S. R. 1 E. W. M.

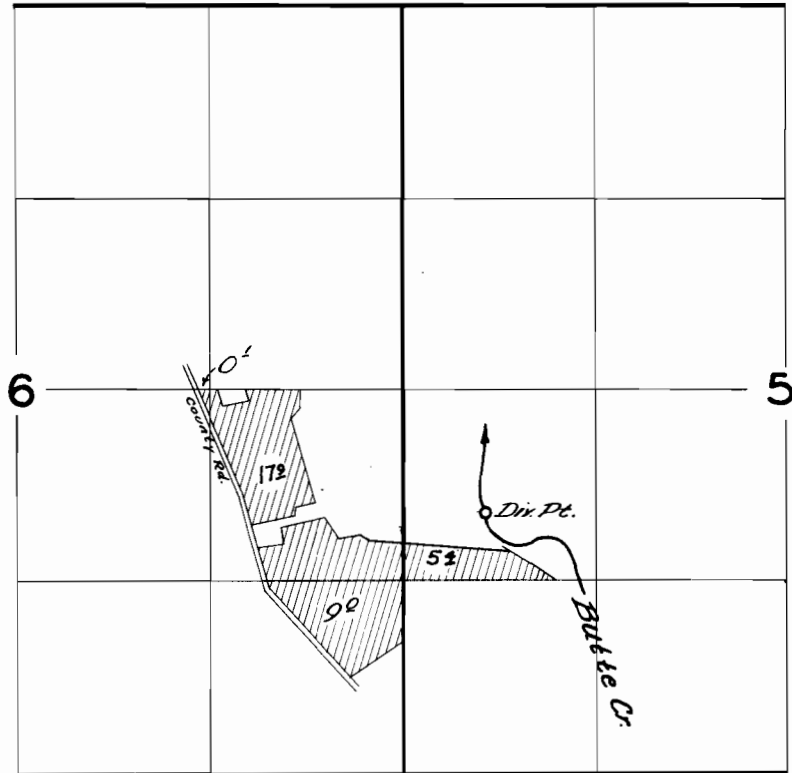

FINAL PROOF SURVEY
UNDER

Application No. *25471* Permit No. *20022*
IN NAME OF

..... *G. G. White*

Surveyed *July 16* 1956, by *M. Bisk*