


T. 5 S. R. 1 W.W.M.

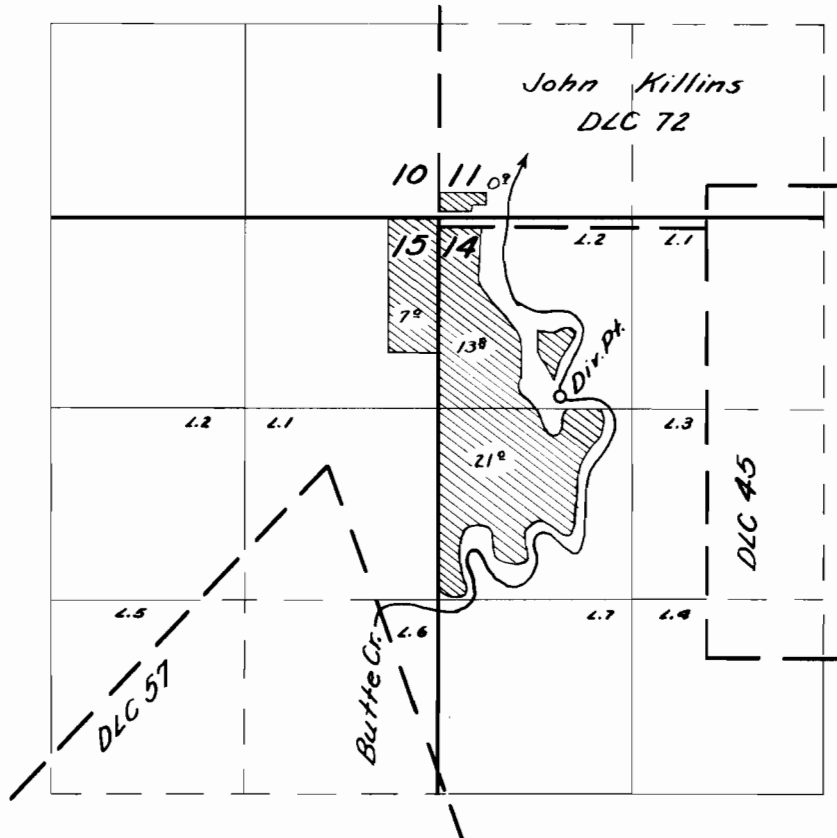

FINAL PROOF SURVEY
UNDER

Application No. 25473 Permit No. 20023
IN NAME OF

John W. & Lora E. Ramage

Surveyed May 28, 1956, by C. O. Bartels