


Per 20035
22776

T. 15 S. R. 31 E. W. M.

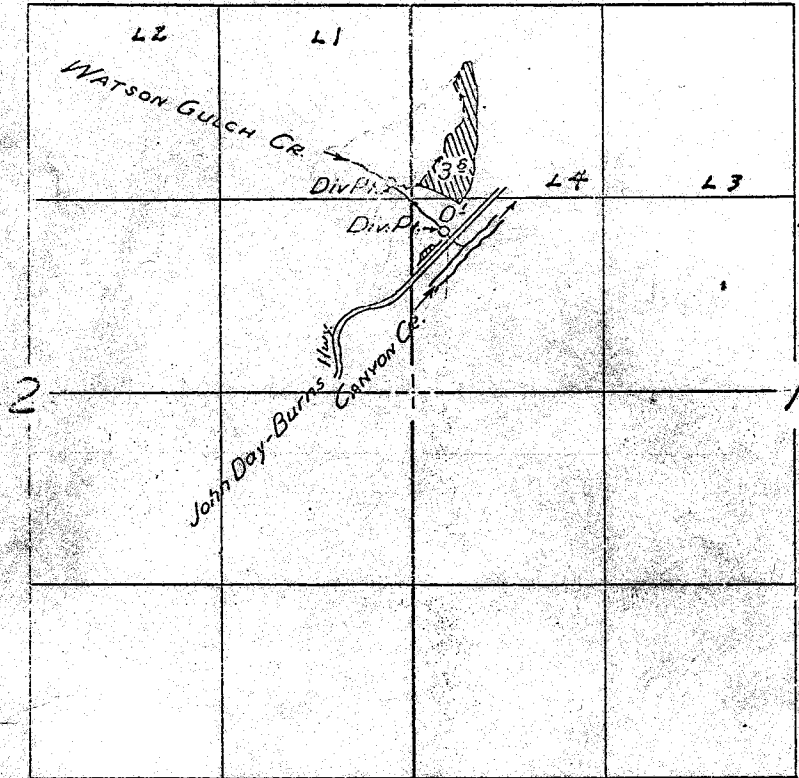

FINAL PROOF SURVEY
UNDER

Application No. 25497 Permit No. 20035

IN NAME OF

E. W. & KATHERINE CRESAP

Surveyed 2 Nov. 1956, by [Signature]