


T.1N., R.3W., W.M.

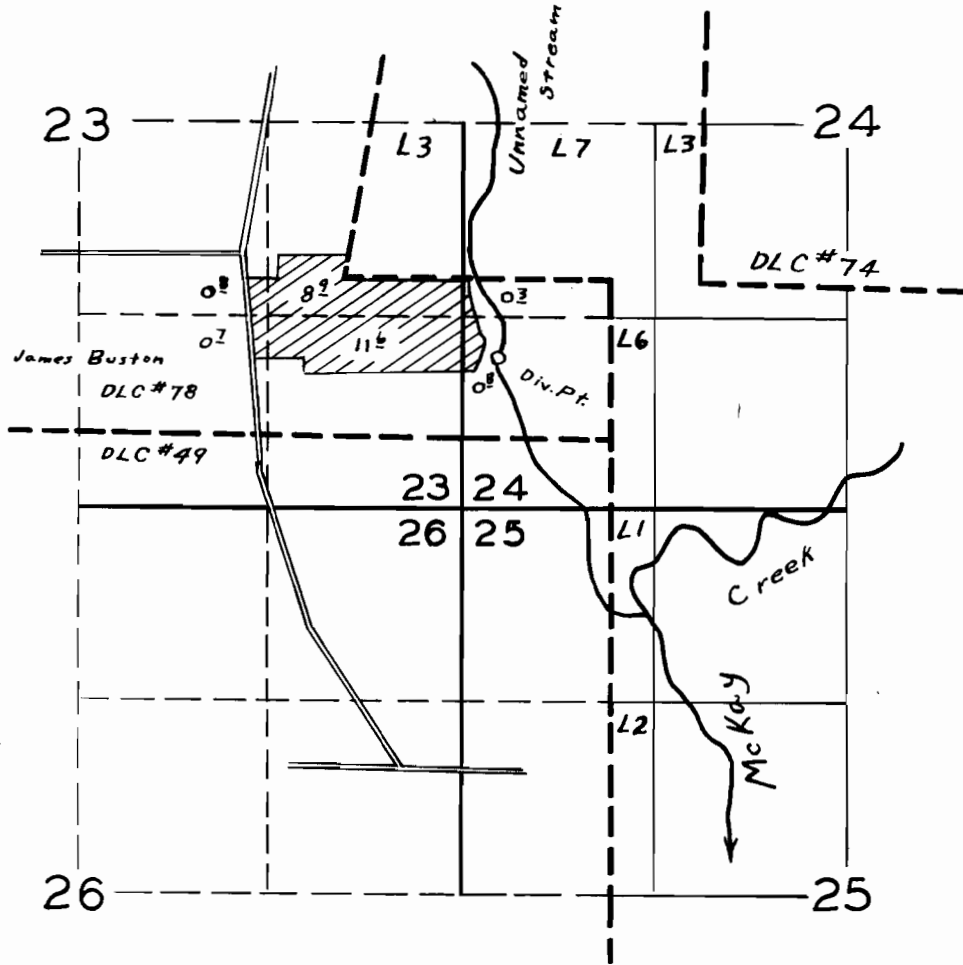

FINAL PROOF SURVEY

UNDER

Application No. 25606 Permit No. 20092

IN NAME OF

LEONARD VAN DOMELEN

Surveyed 4-11-1956, by R. H. WHITBY