


T. 4 N. R. 1 & 2 W. W. M.

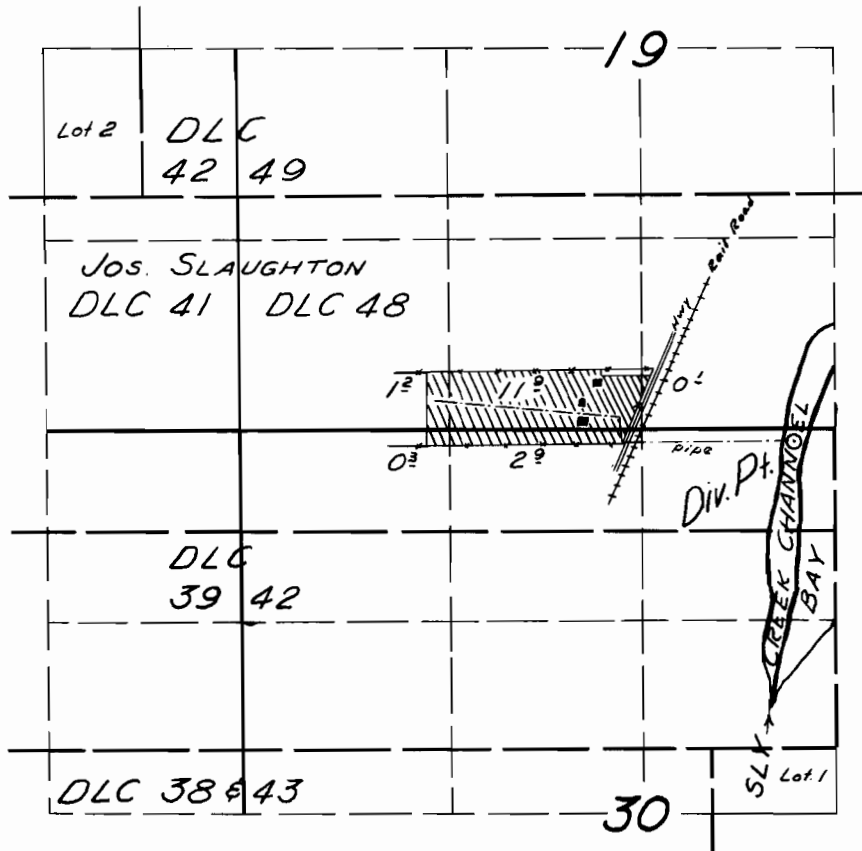

FINAL PROOF SURVEY

UNDER


Application No. 18552 Permit No. 14178

IN NAME OF

F. W. BOESEL

Surveyed 8 Aug. 1951, by H. L. COFFMAN

T. 4 N. R. 1 E. 2 W. W. M.

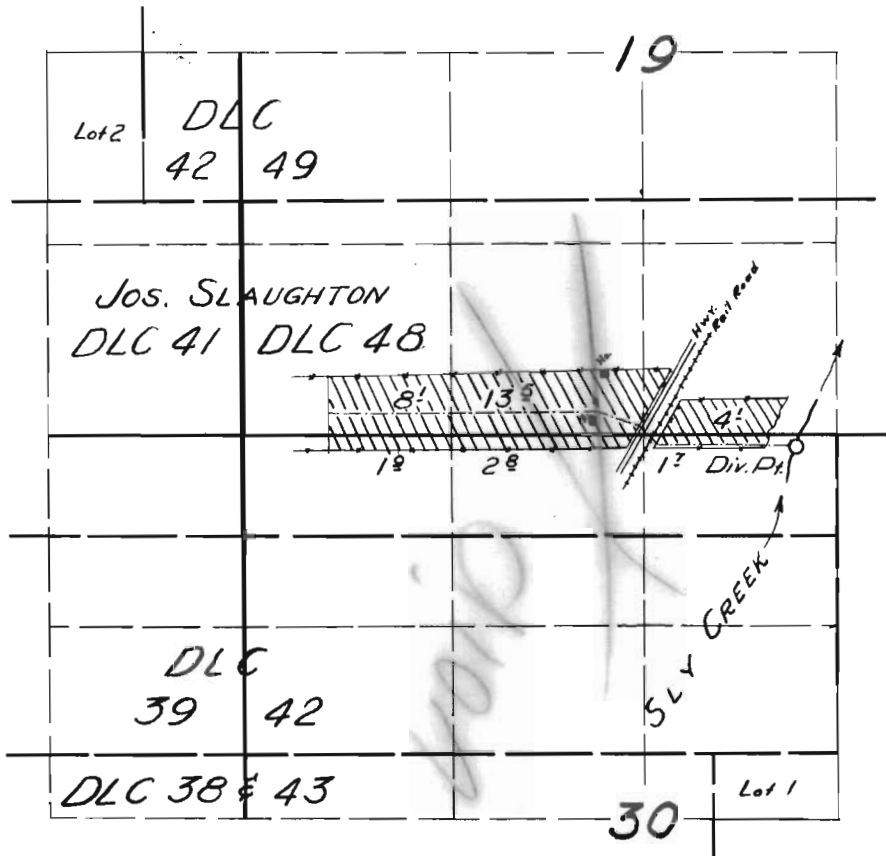

FINAL PROOF SURVEY
UNDER

Application No. 18552 Permit No. 14178

IN NAME OF

F. W. BOESEL

Surveyed 10 July 1956, by [Signature]

T.4N.R.1W.W.M.

*Garnett Foster
CL 49*

19


*Check back
lines
with yellow class*



Map No. 6

*No good is
right*

*Part of
resurvey C142*

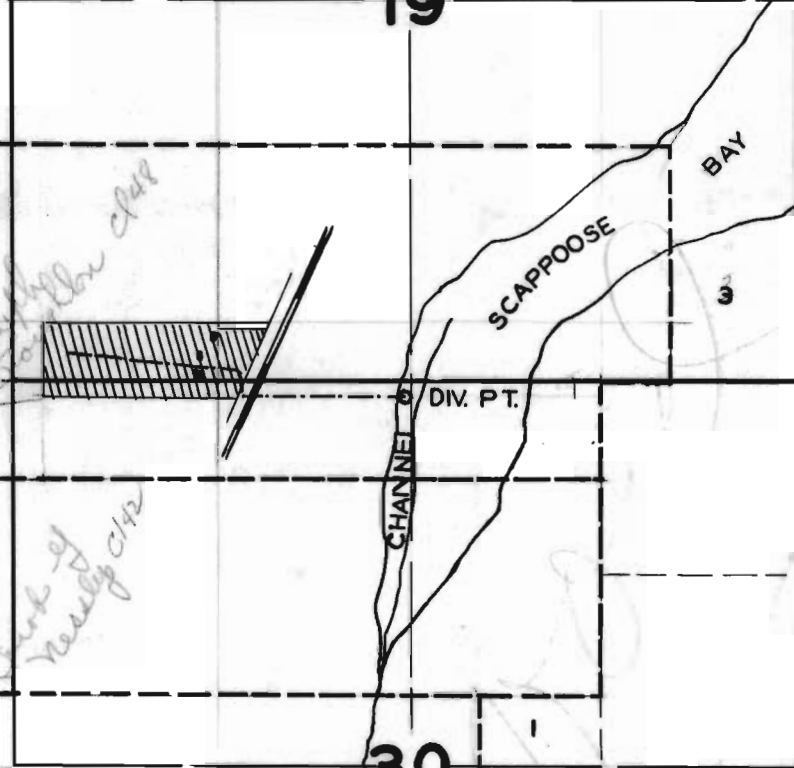

30

SLY CR

FINAL PROOF SURVEY

UNDER

Application No. 18552 Permit No. 14178

IN NAME OF

F. W. BOESEL

Surveyed AUG. 8, 1951, by H.L. COFFMAN