


T. 8 S. R. 2 W. W.M.

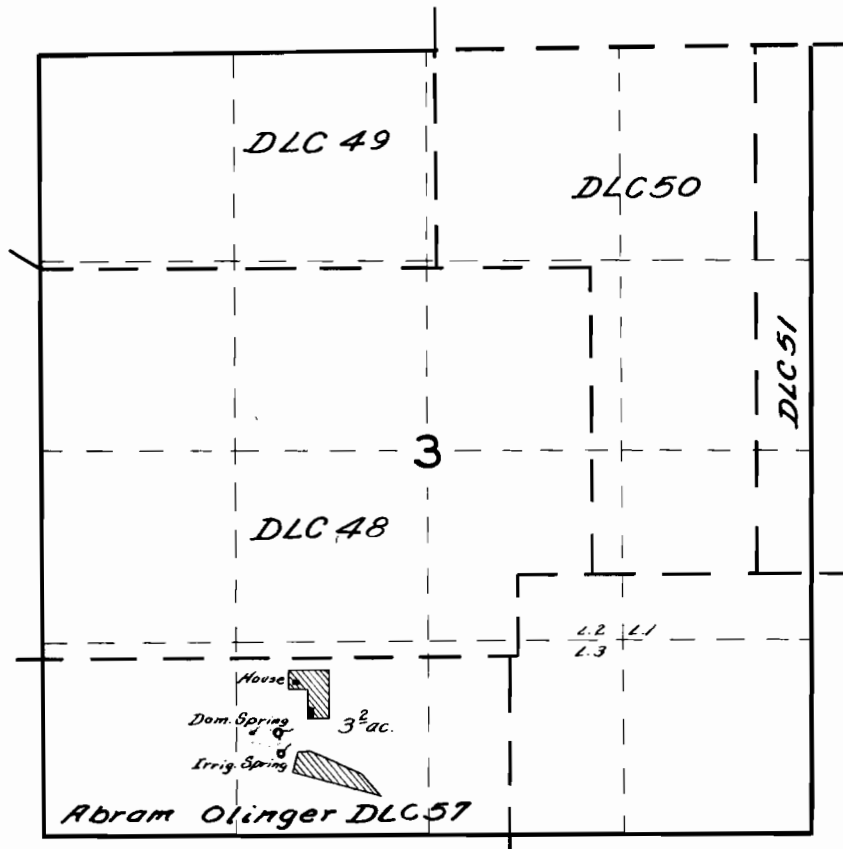

FINAL PROOF SURVEY

UNDER

Application No. *19672* Permit No. *15253*

IN NAME OF

Lester C. Davidson

Surveyed *May 22 1956*, by *R.H. Whitby*

DFN-2D-61