


19096
22789

T.39S., R.10E.W.M.

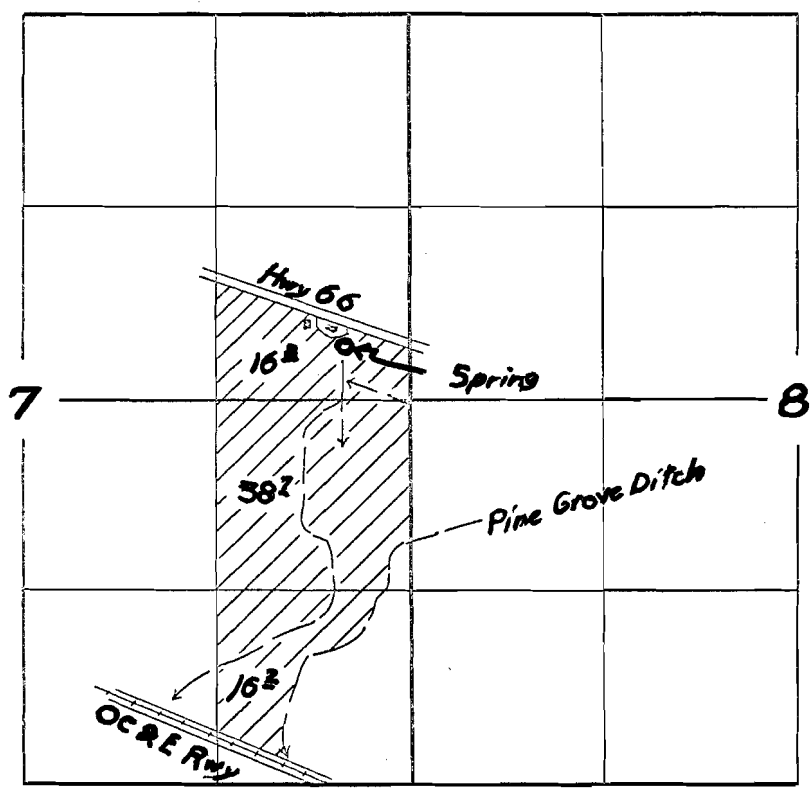

East River misc.

FINAL PROOF SURVEY
UNDER

Application No. 23962. Permit No. 19096.
IN NAME OF

ROBERT J. & CARMEN J. EMBREE.

Surveyed 19 May, 1955, by H.L. Coffman.