


T.5S.R.3W.W.M.

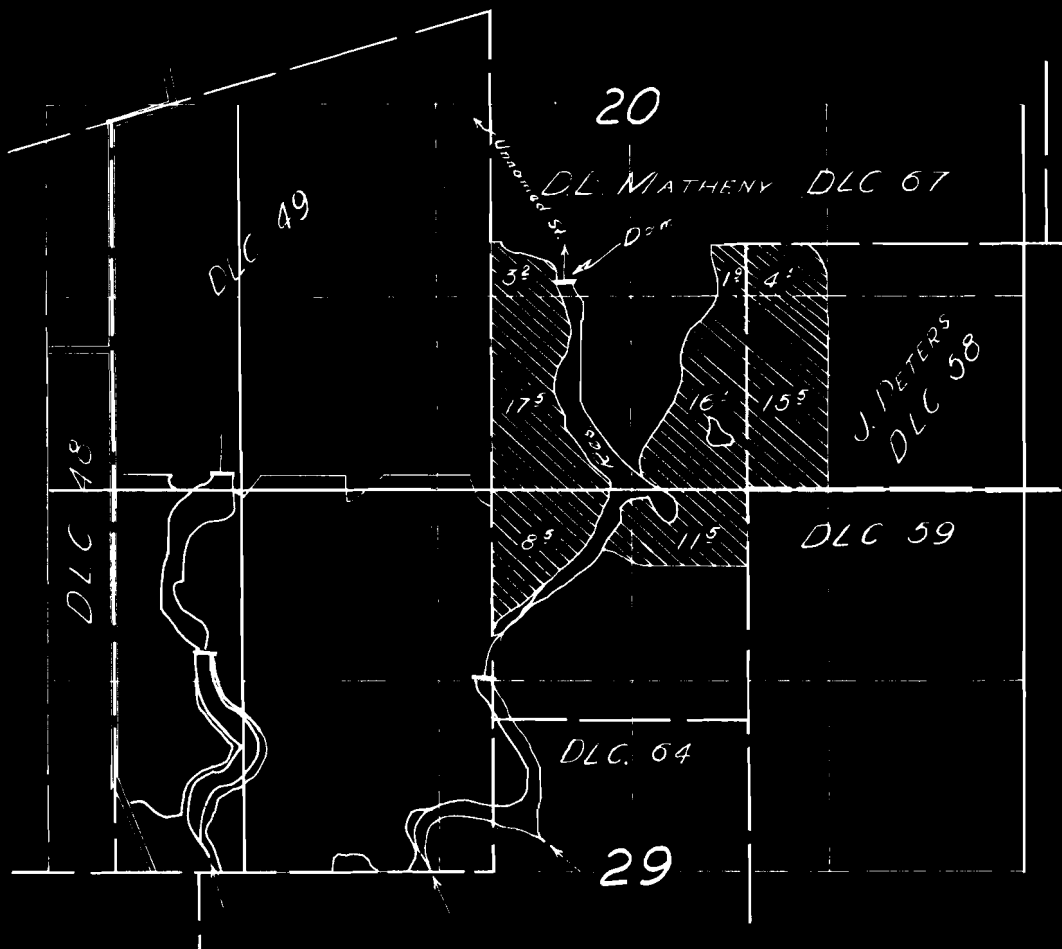

R-23301
23302

R-951
18437

L. C. CAMPBELL

25 May 56 T. JONES