


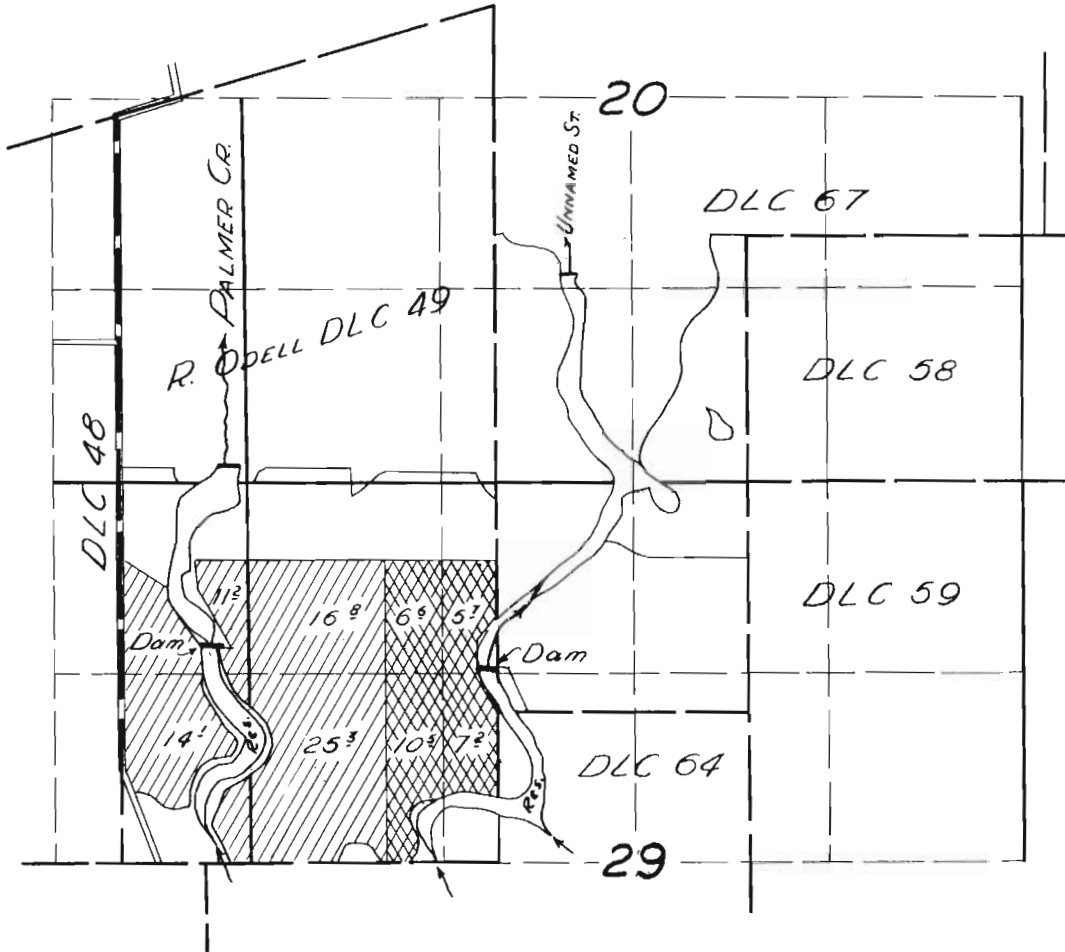

T.5S.R.3W.W.M.



FINAL PROOF SURVEY

23304	18438	} 
R-23303	R-952	
26647	21014	} 
Application No. R-26380	Permit No. R-1308	

IN NAME OF

VICTORIA CAMPBELL

Surveyed 26 Mar 1956, by *[Signature]*

(copy)