


T. 9 S. R. 2 W. W.M.

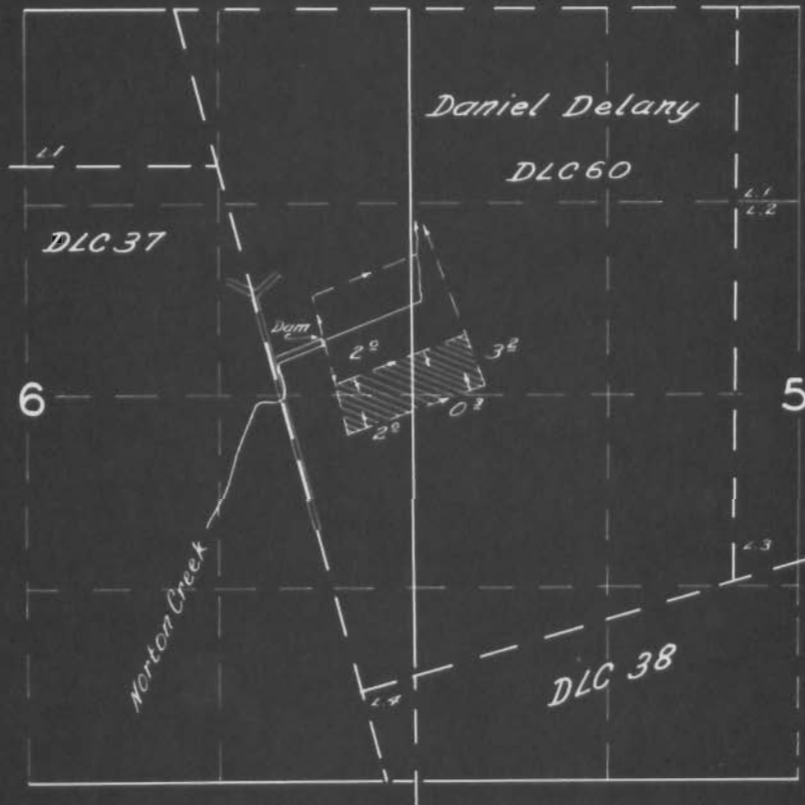

FINAL PROOF SURVEY

UNDER

Application No. *R-24629* 24630 Permit No. *R-1026* 19391

IN NAME OF

*A. S. Drager*

Surveyed *May 21 1956*, by *R.H. Whitby*

DFN-3D-129