


T. 4 N. R. 2 W. W. M.

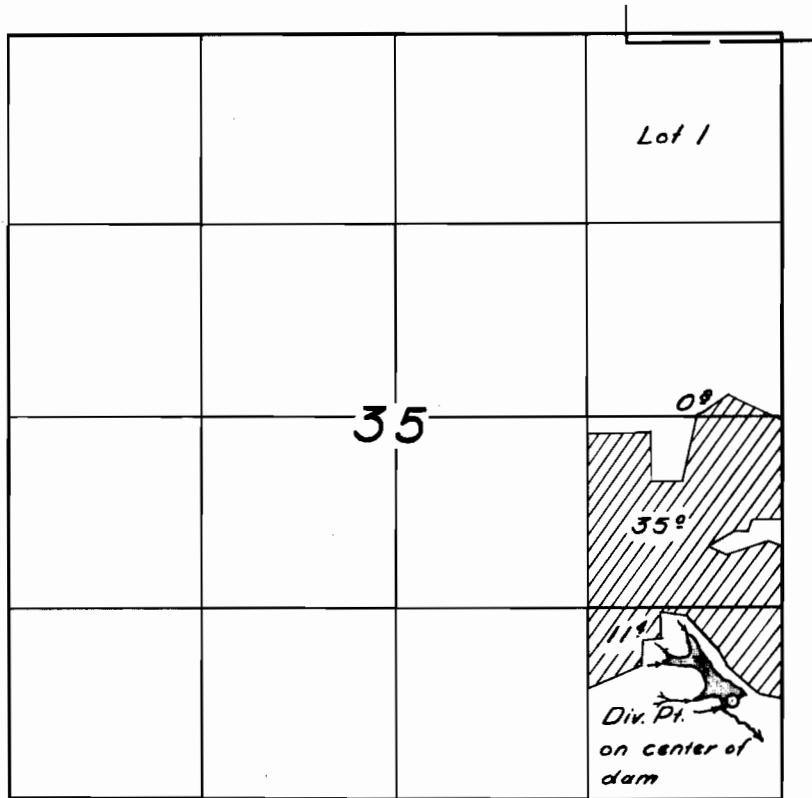

FINAL PROOF SURVEY

UNDER

R-24867

R-1045

Application No. 24092 Permit No. 19489

IN NAME OF

CLARK W. SHERMAN

Surveyed 12 July 1956, by C. H. Hilby