


T. 5 S. R. 3 W. W. M.

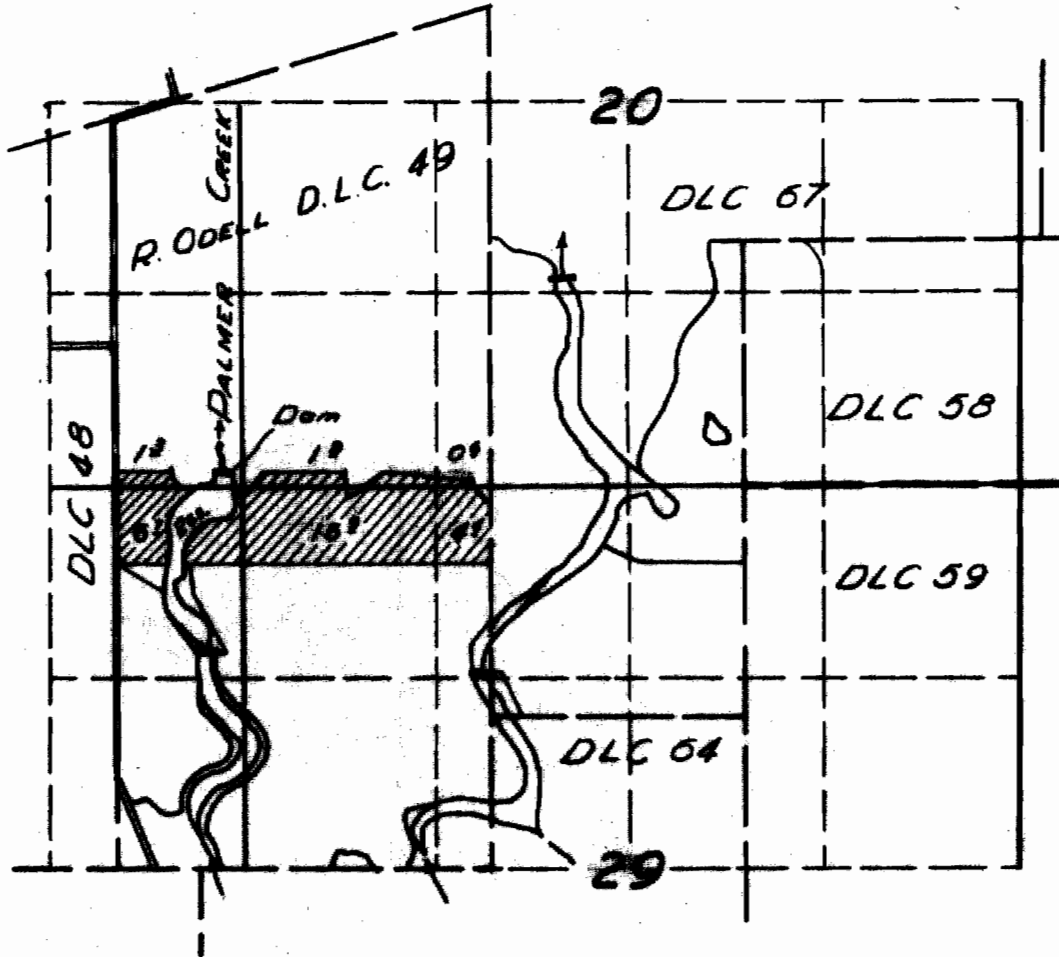

FINAL PROOF SURVEY

UNDER

R-25167

R-1097

Application No. 25168 Permit No. 19954

IN NAME OF

L. C. CAMPBELL

Surveyed 26 Mar. 1956, by [Signature]