T. 5 S. R. 3 W. W. M.

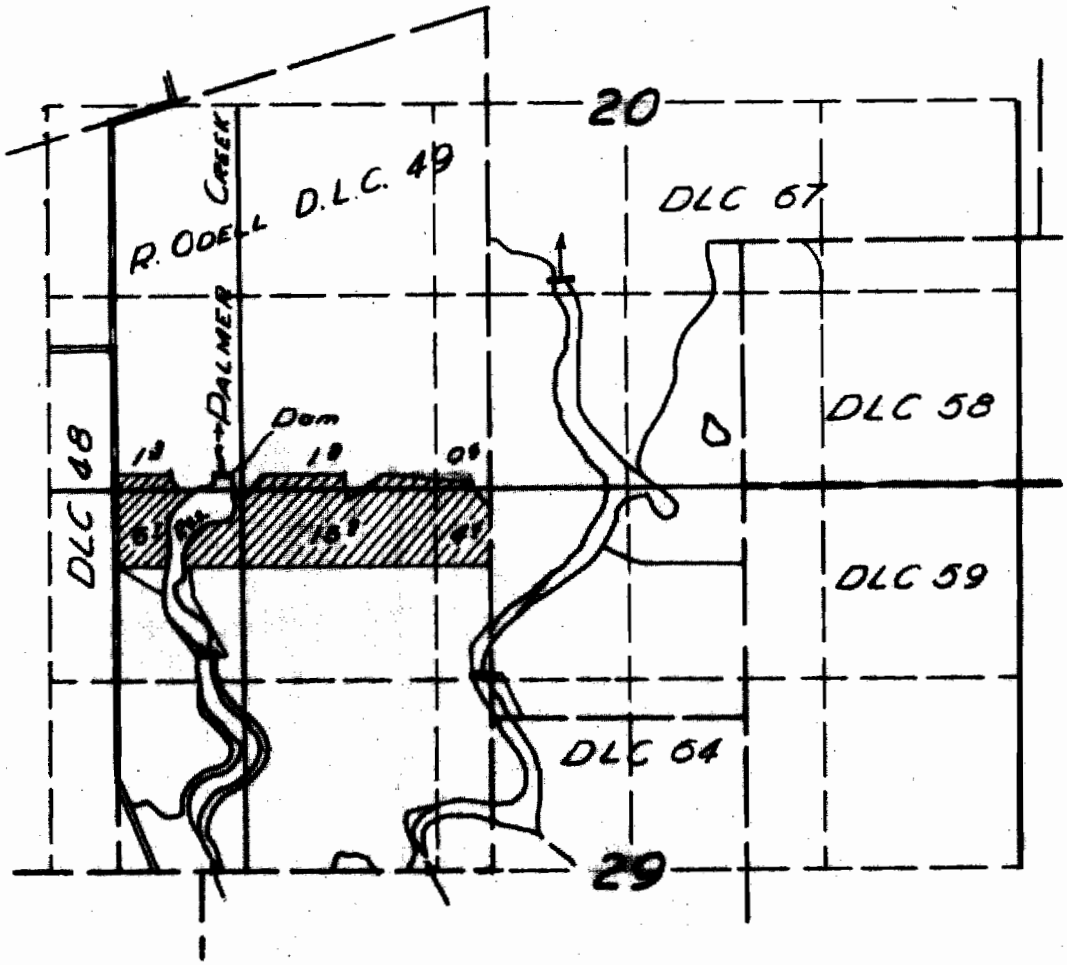

FINAL PROOF SURVEY

UNDER

Application No. R-25167 25168 Permit No. R-1097 19954

IN NAME OF

L. C. CAMPBELL

Surveyed 26 Mar. 1956, by [signature]

DFQ-30-158