


T. 30 S. R. 6 W. W. M.

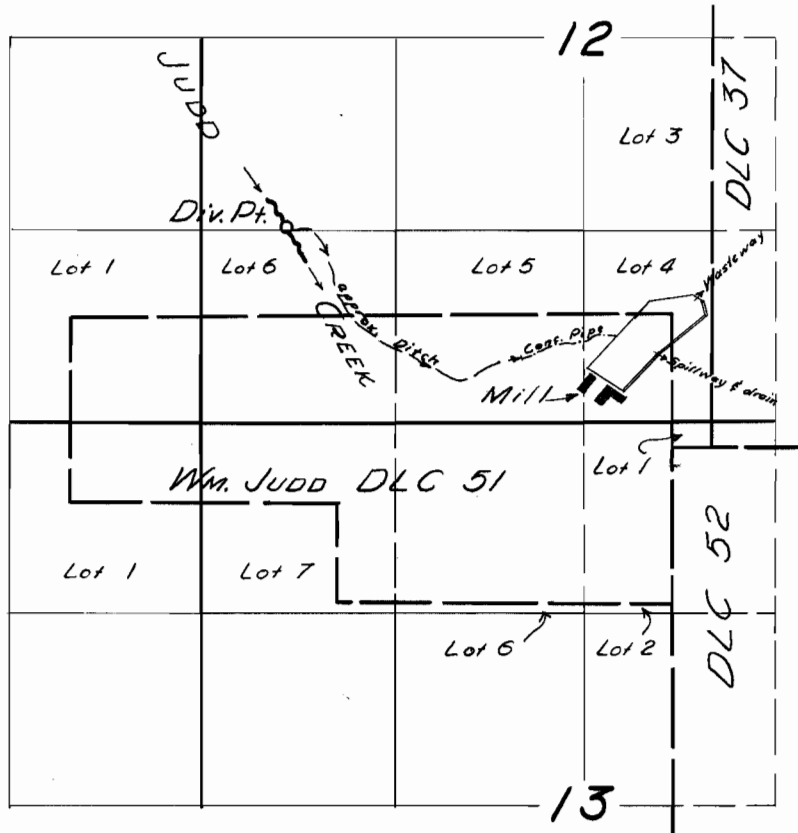

FINAL PROOF SURVEY

UNDER

R-25742, R-1155

Application No. 25785 Permit No. 20277

IN NAME OF

LOREN H. CORDER

Surveyed 17 Oct. 1956, by *C. H. Skelton*