


Range 24 E.W.M.

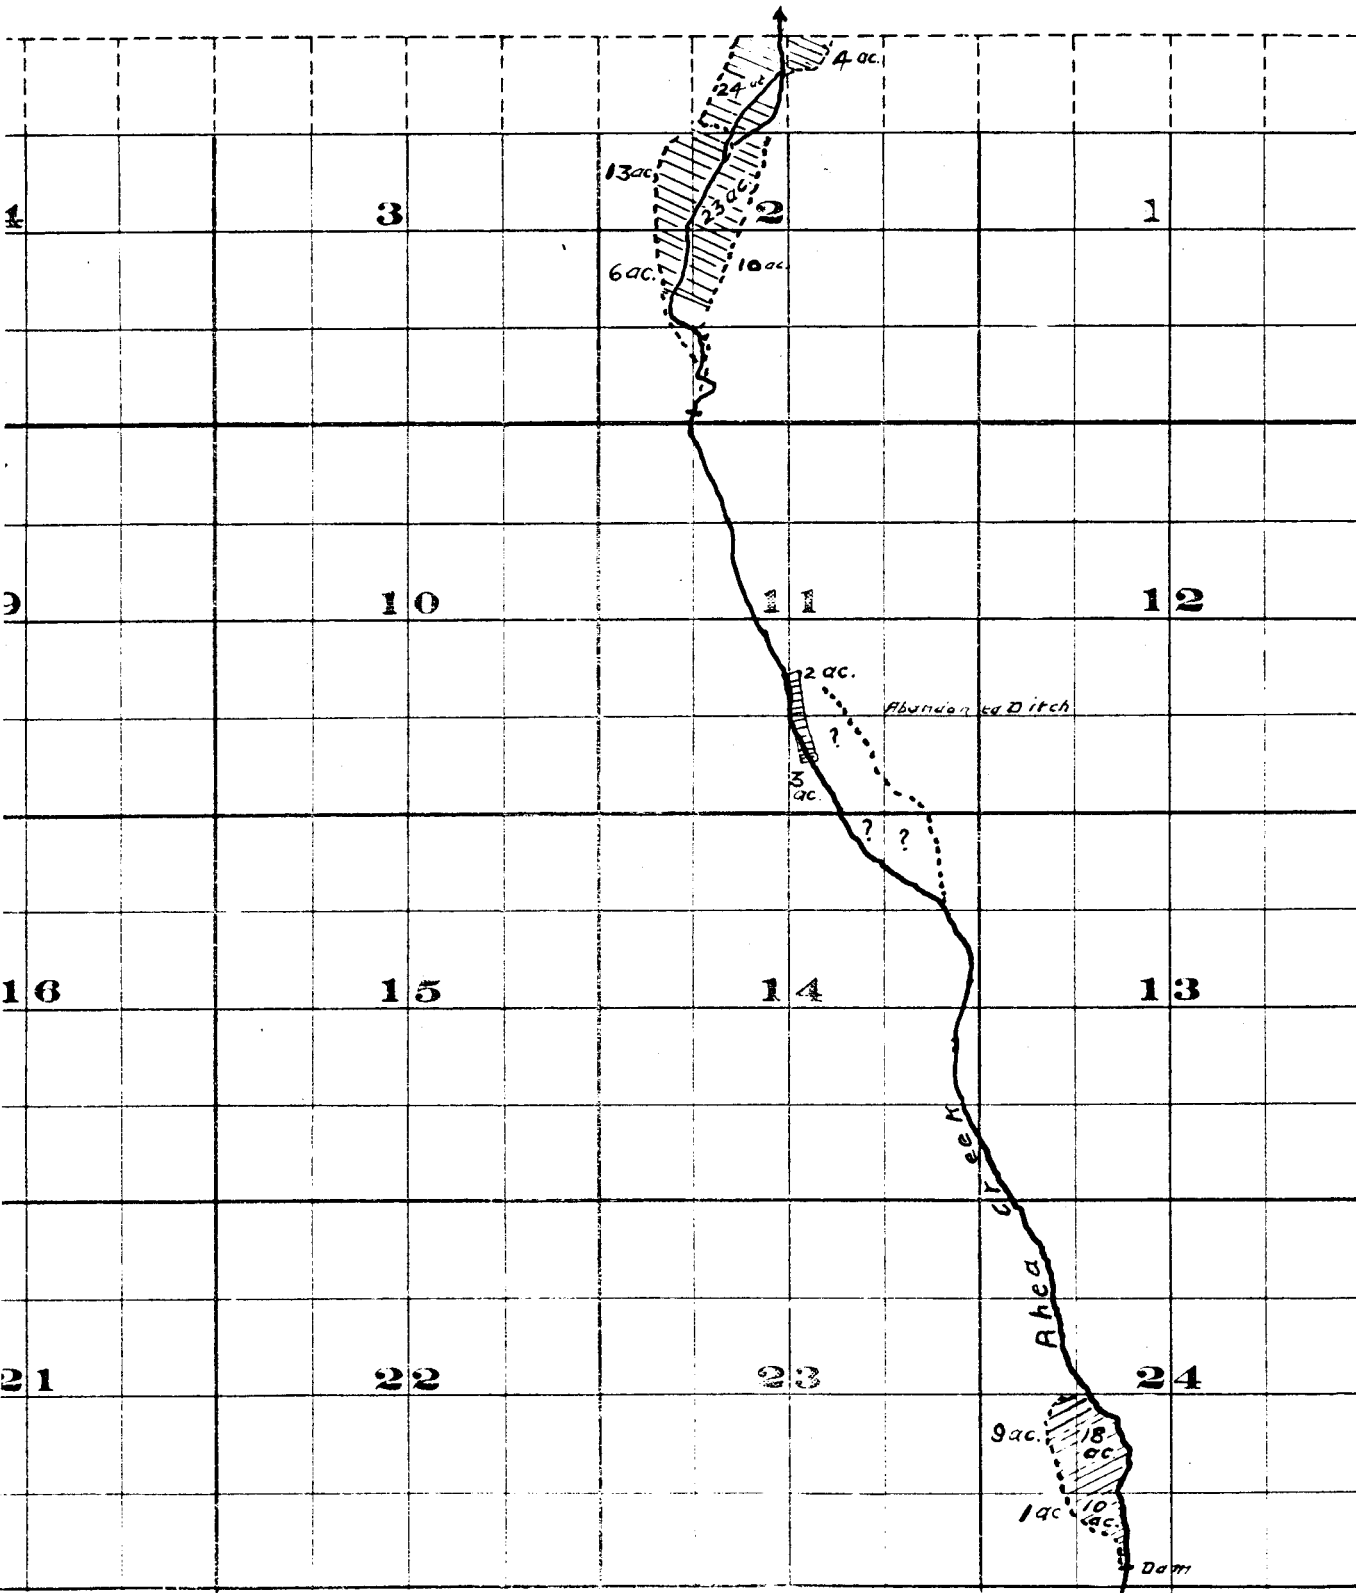

Township 2 S.

[illegible]


7		8		9		10
18		17		16		15
19		20		21		22
30		29		28		27
31		32		33		34


Surveyed by R.D. Cooper July 1909

John H. Lewis - State Engineer.

Examined July 14, 1909.

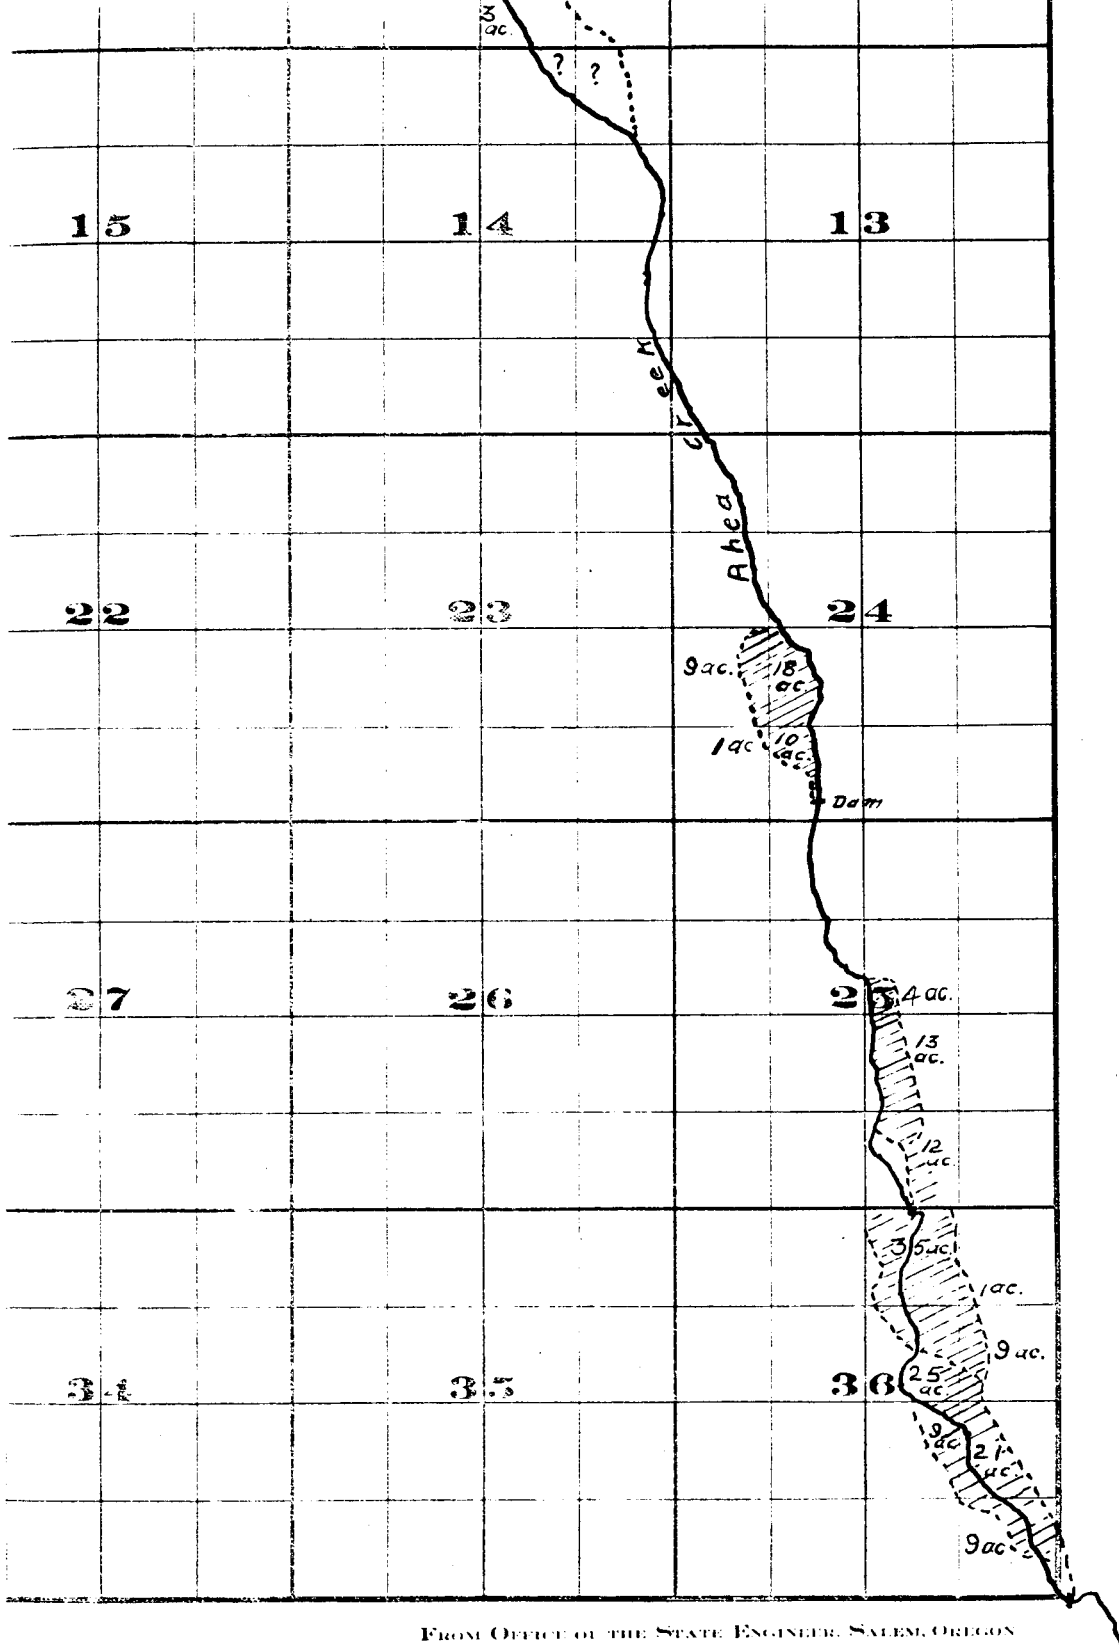

FROM OFFICE OF THE STATE ENGINEER, SALEM, OREGON

Willow Creek Adjudication.

2 S. 24 E.