


T. 39 S., R. 2 E., W.M.

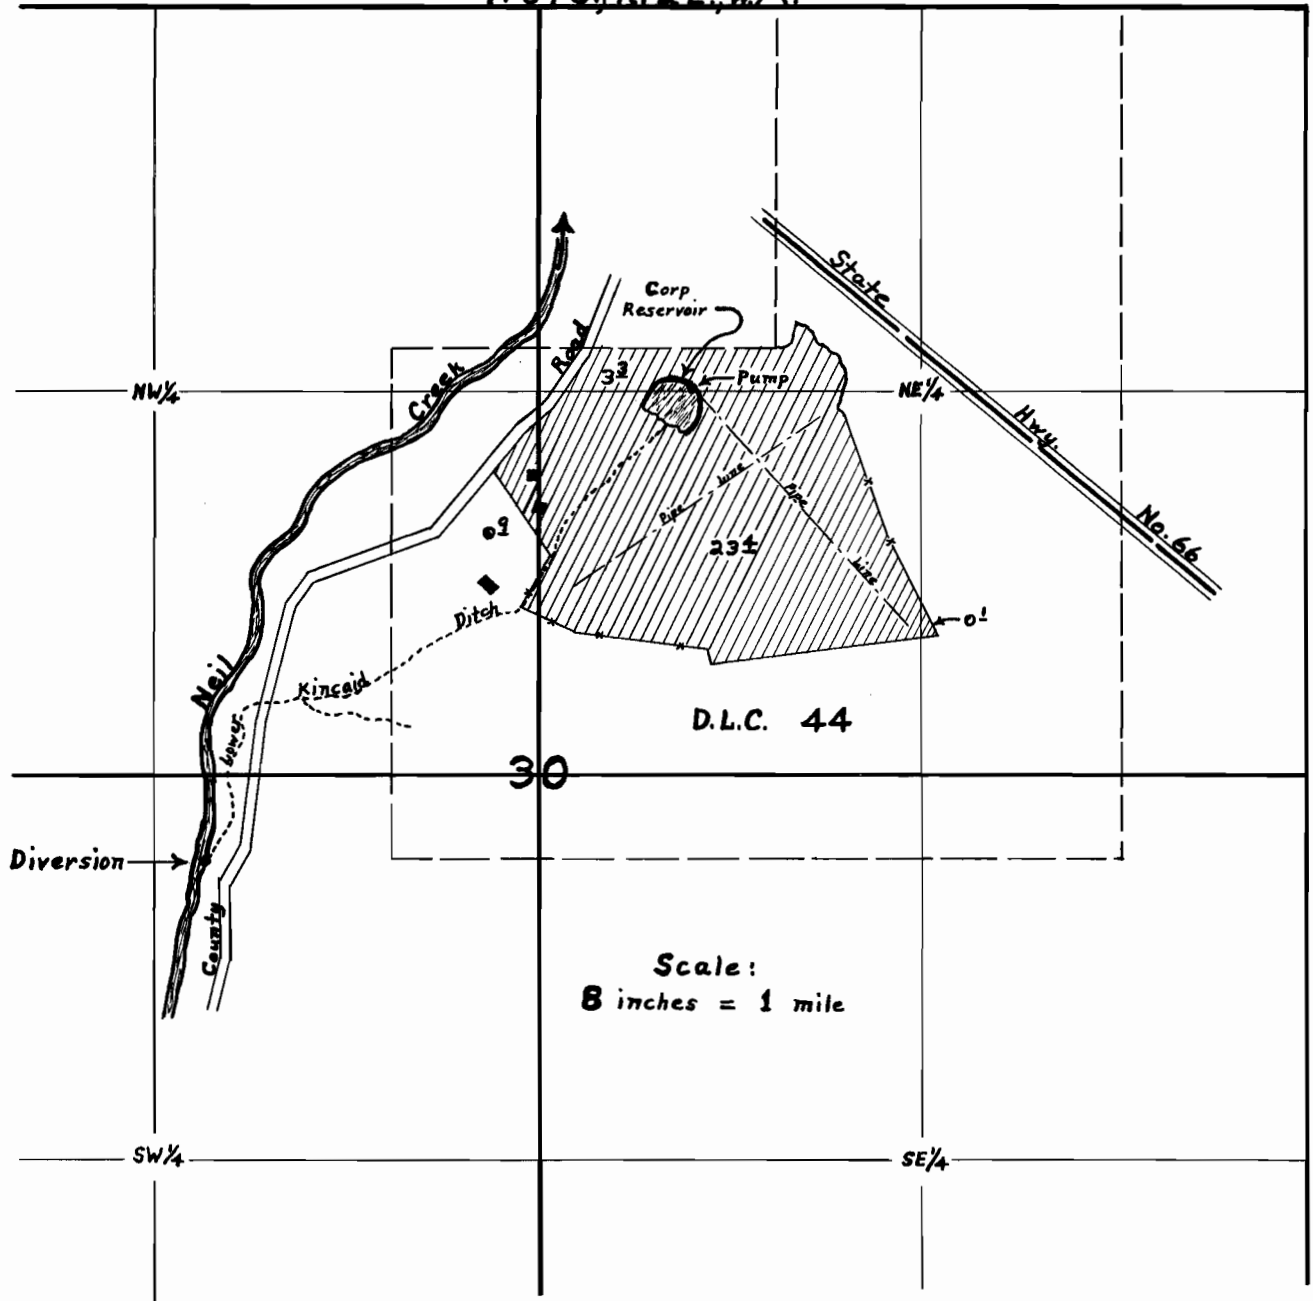

FINAL PROOF SURVEY

UNDER

Application No. R-25902 25903 Permit No. R-1213 20538

IN NAME OF

K.W. Corp. by O.L. Wright, Manager

Surveyed Feb. 14 1957, by D.C. Hendrix, W.M.