


T. 1 N. R. 3 E. W. M.

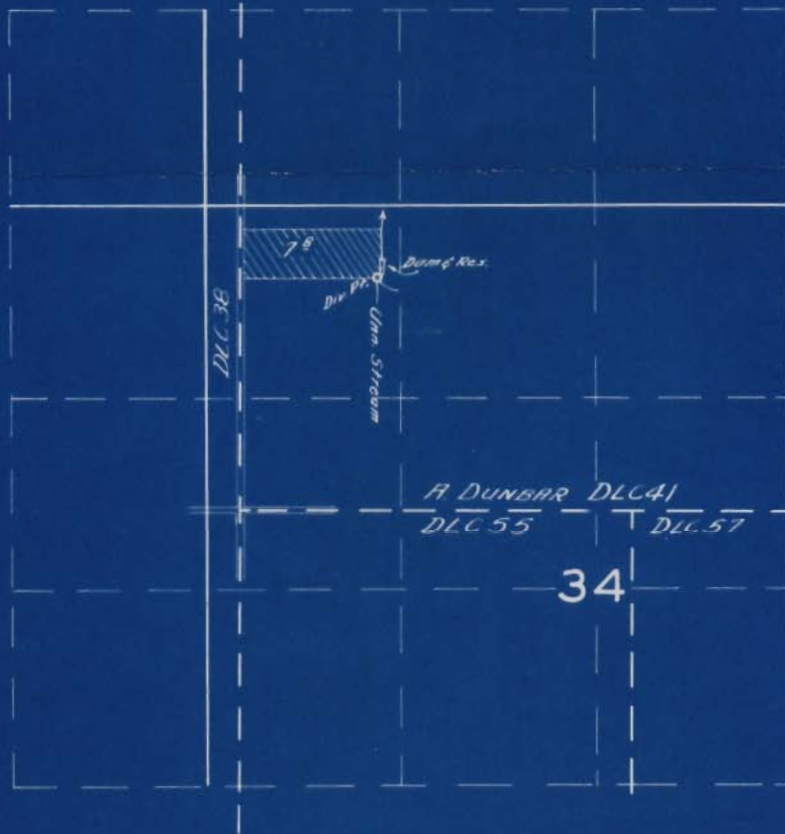

FINAL PROOF SURVEY

UNDER

Application No. R-26111 26117 Permit No. R-1226 20579

IN NAME OF

MOLLER'S NURSERY

Surveyed June 30, 1956, by R.H. Whitby

DFK-10-156

C.B.