


T. 1 N. R. 3 E. W. M.

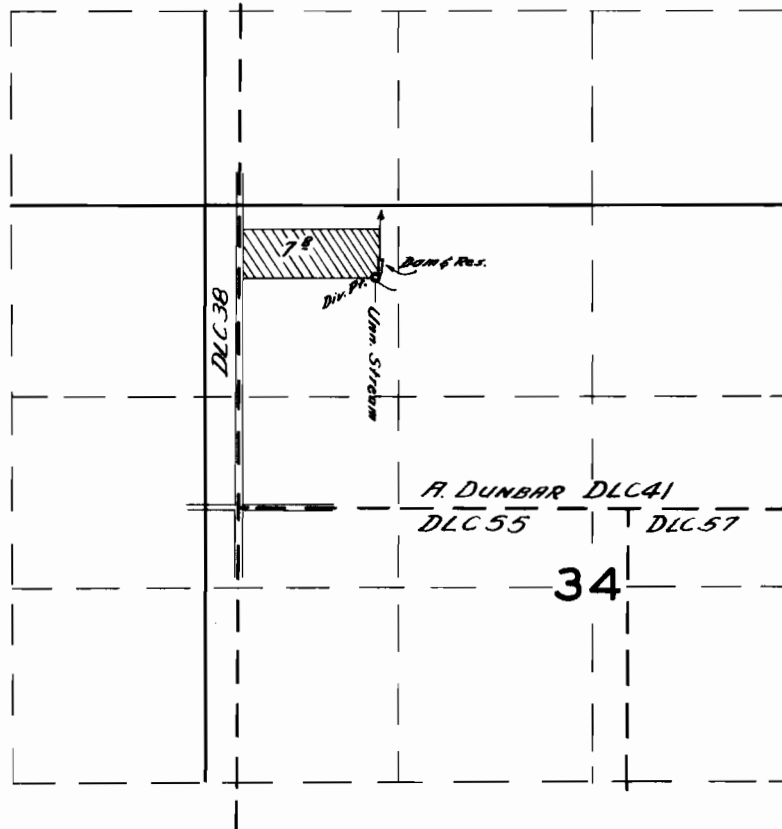

FINAL PROOF SURVEY

UNDER

Application No. *R-26111* *26117* Permit No. *R-1226* *20579*

IN NAME OF

MOLLER'S NURSERY

Surveyed *June 30, 1956*, by *R.H. Whitby*

DFK-10-156

C.B.